


T.27S. R.15E., W.M.

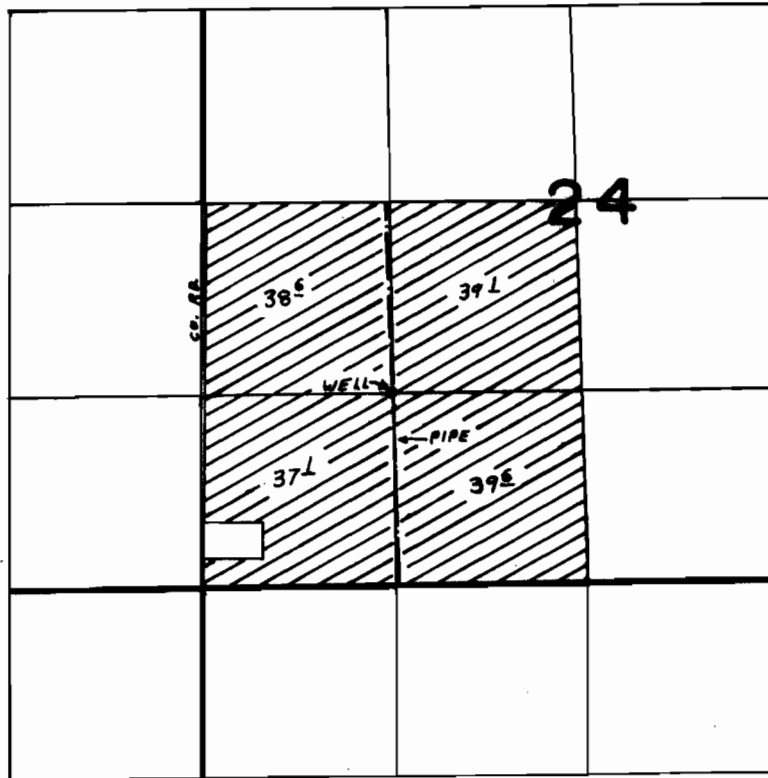

WELL LOC. 1320' N. + 1290' E. FROM S.W. COR SEC. 24

FINAL PROOF SURVEY
UNDER

Application No. G-6303 Permit No. G-5925
IN NAME OF

DARREL G. BOWEN

Surveyed JUL 18, 1977, by D.M. NORBY