

FINAL PROOF SURVEY for

JOHN C. MUSSER in the

NW $\frac{1}{4}$, SW $\frac{1}{4}$, Section 34

T 39 S, R 14 W, W.M.


Curry County, Oregon

Application No. 72214

Permit No. 51562

scale: 1" = 660'

May, 1995

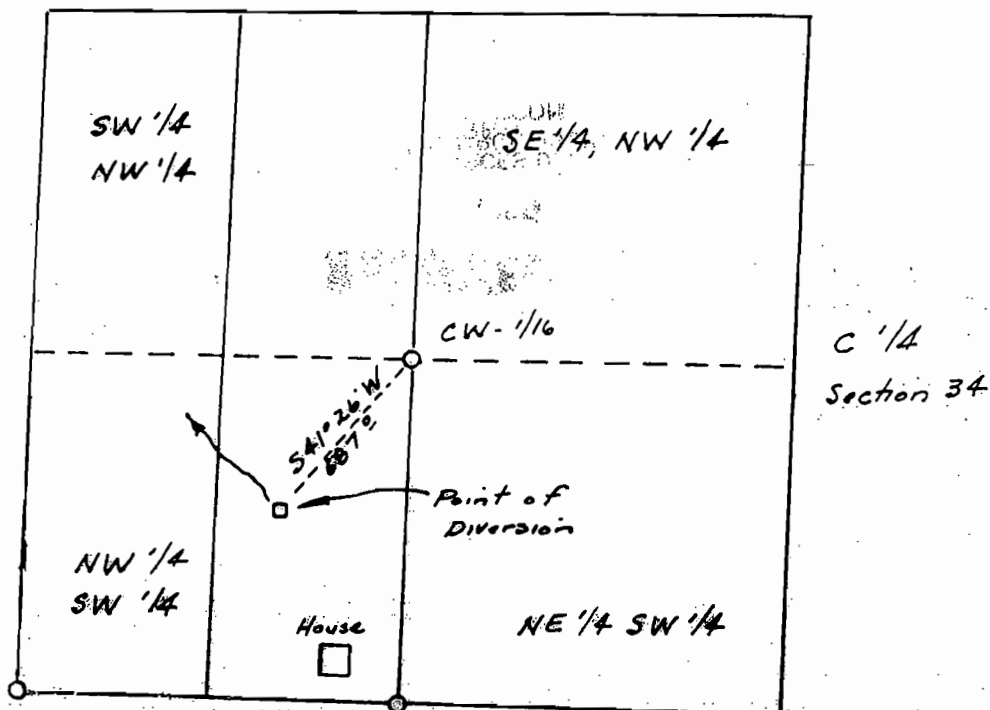

The purpose of this map is to identify the location of a water right. It is not intended to give information relative to the location of property ownership lines.

RECEIVED

JUN 22 1995

WATER RESOURCES DEPT.
SALEM, OREGON



Donald Cormack, CWRE
P.O. Box 1280
Brookings, Oregon