


T. 41 S., R. 21 E., W.M.

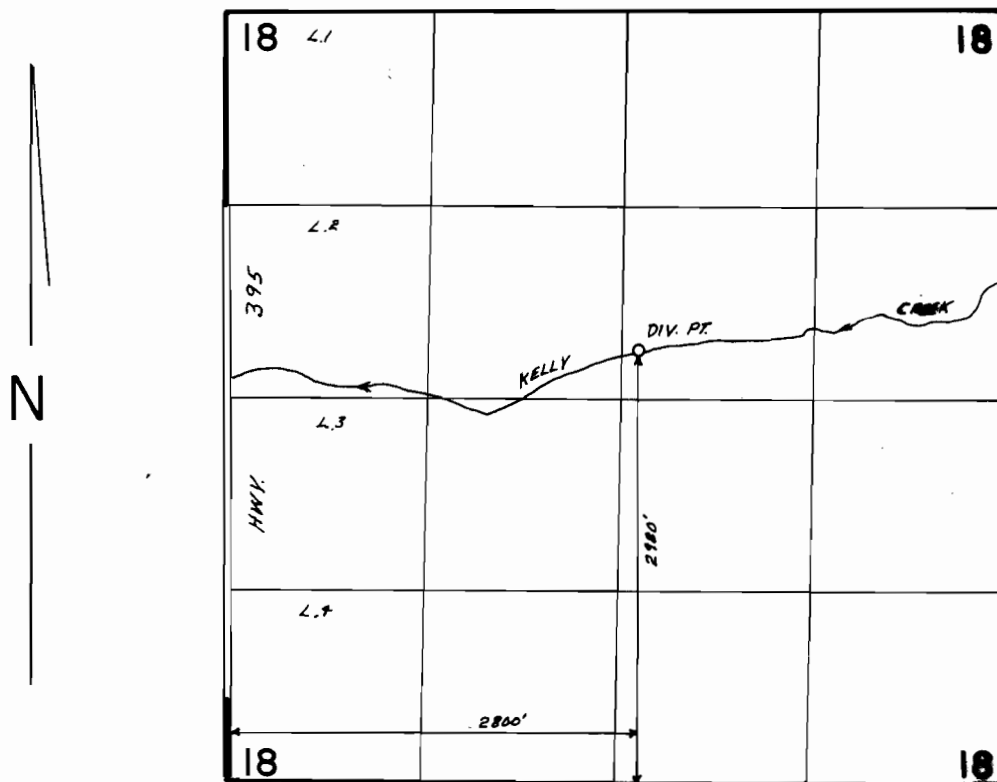

SCALE: 1"=1320'

FINAL PROOF SURVEY
UNDER

TRANSFER 5327

IN NAME OF

JOHN BRYANT

Surveyed OCT. 19. 1988, by B. BISHOP