


JUN 7 1999

WATER RESOURCES DEPT.
SALEM, OREGON

T 3 S R 40 E

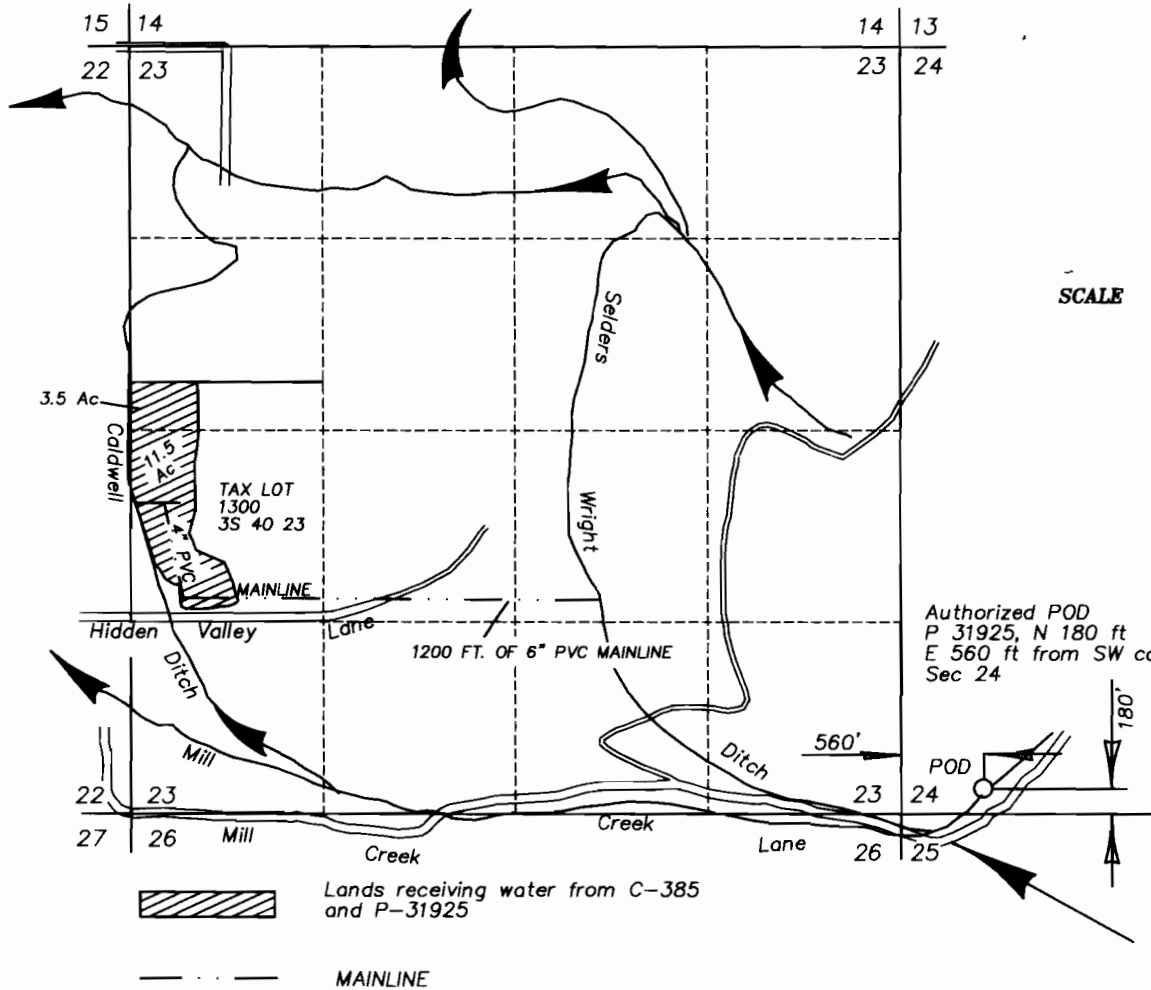

SCALE 1" = 1320'



FINAL PROOF MAP OF
TRANSFER OF PLACE OF USE
FOR


John M. & Roberta E. Miller

BY
BAGETT - GRIFFITH & BLACKMAN
2006 ADAMS AVENUE
LAGRANDE, OREGON 97850

APRIL 7, 1999

APPLICATION NO. = T-7938

PERMIT NUMBER _____

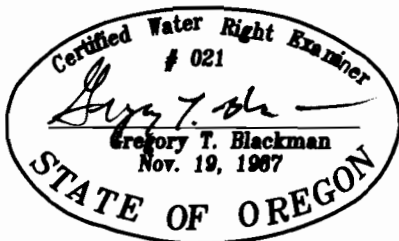

NOTE: The preparation of this map was for the purpose of identifying the location of the proposed water right and has no intent to provide dimensions or location of property ownership lines. Location information shown hereon was furnished by the applicant.