


NOTE: The preparation of this map was for the purpose of identifying the location of the proposed water right and has no intent to provide dimensions or location of property ownership lines.

FINAL PROOF SURVEY
UNDER PERMIT
NUMBER 51521

FOR
John D. and Katherine I. Arrand
BY
BAGETT - GRIFFITH & BLACKMAN
2006 ADAMS AVENUE
LAGRANDE, OREGON 97850

July 19, 1995
APPLICATION NO 69694
PERMIT NUMBER 51521

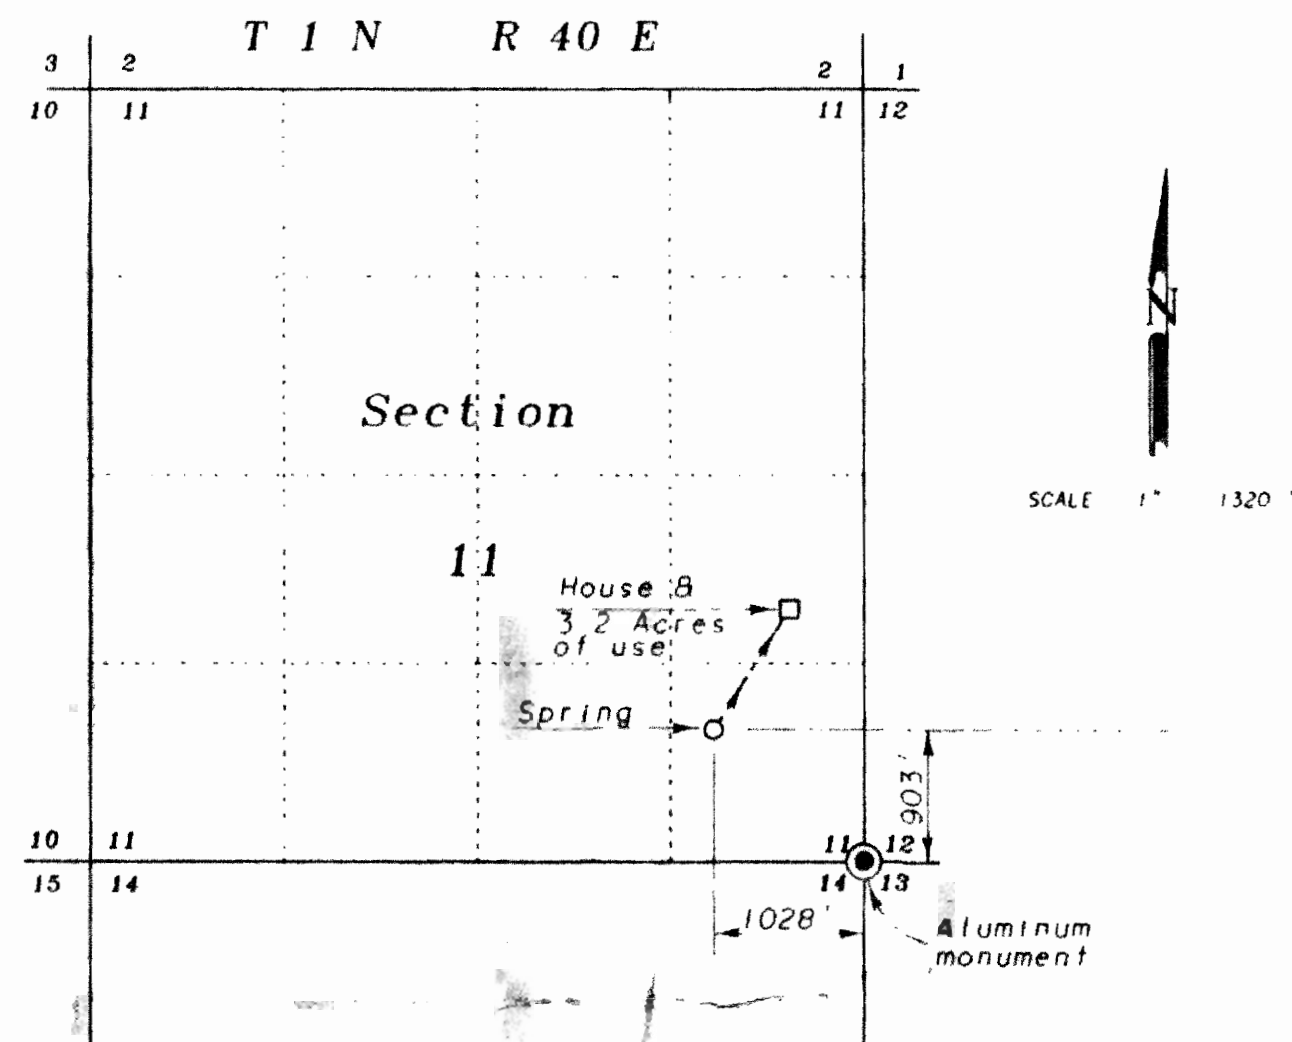