


T.17S. R.20E. W.M.

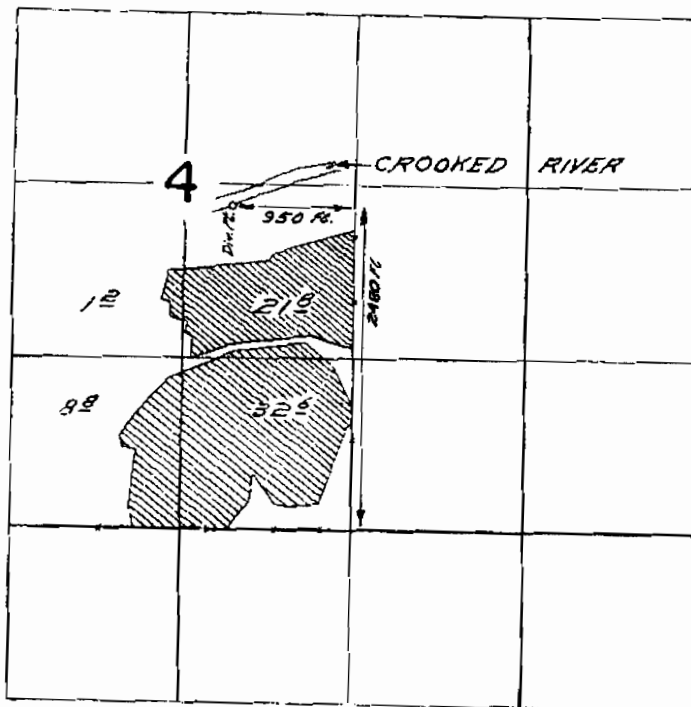

FINAL PROOF SURVEY
UNDER

Application No. 34950 Permit No. 27410
IN NAME OF

CLYDE WAYLAND

Surveyed *Mar. 8, 1968*, by *W. J. Ruppert*