


MAP OF
WATER PERMIT SURVEY
 IN SEC. 16 - T.29S.R.12W.W.M.
 FOR
HORACE N. WARNER
 SCALE 1" = 500' E.L. VINTON
 MARCH 1925

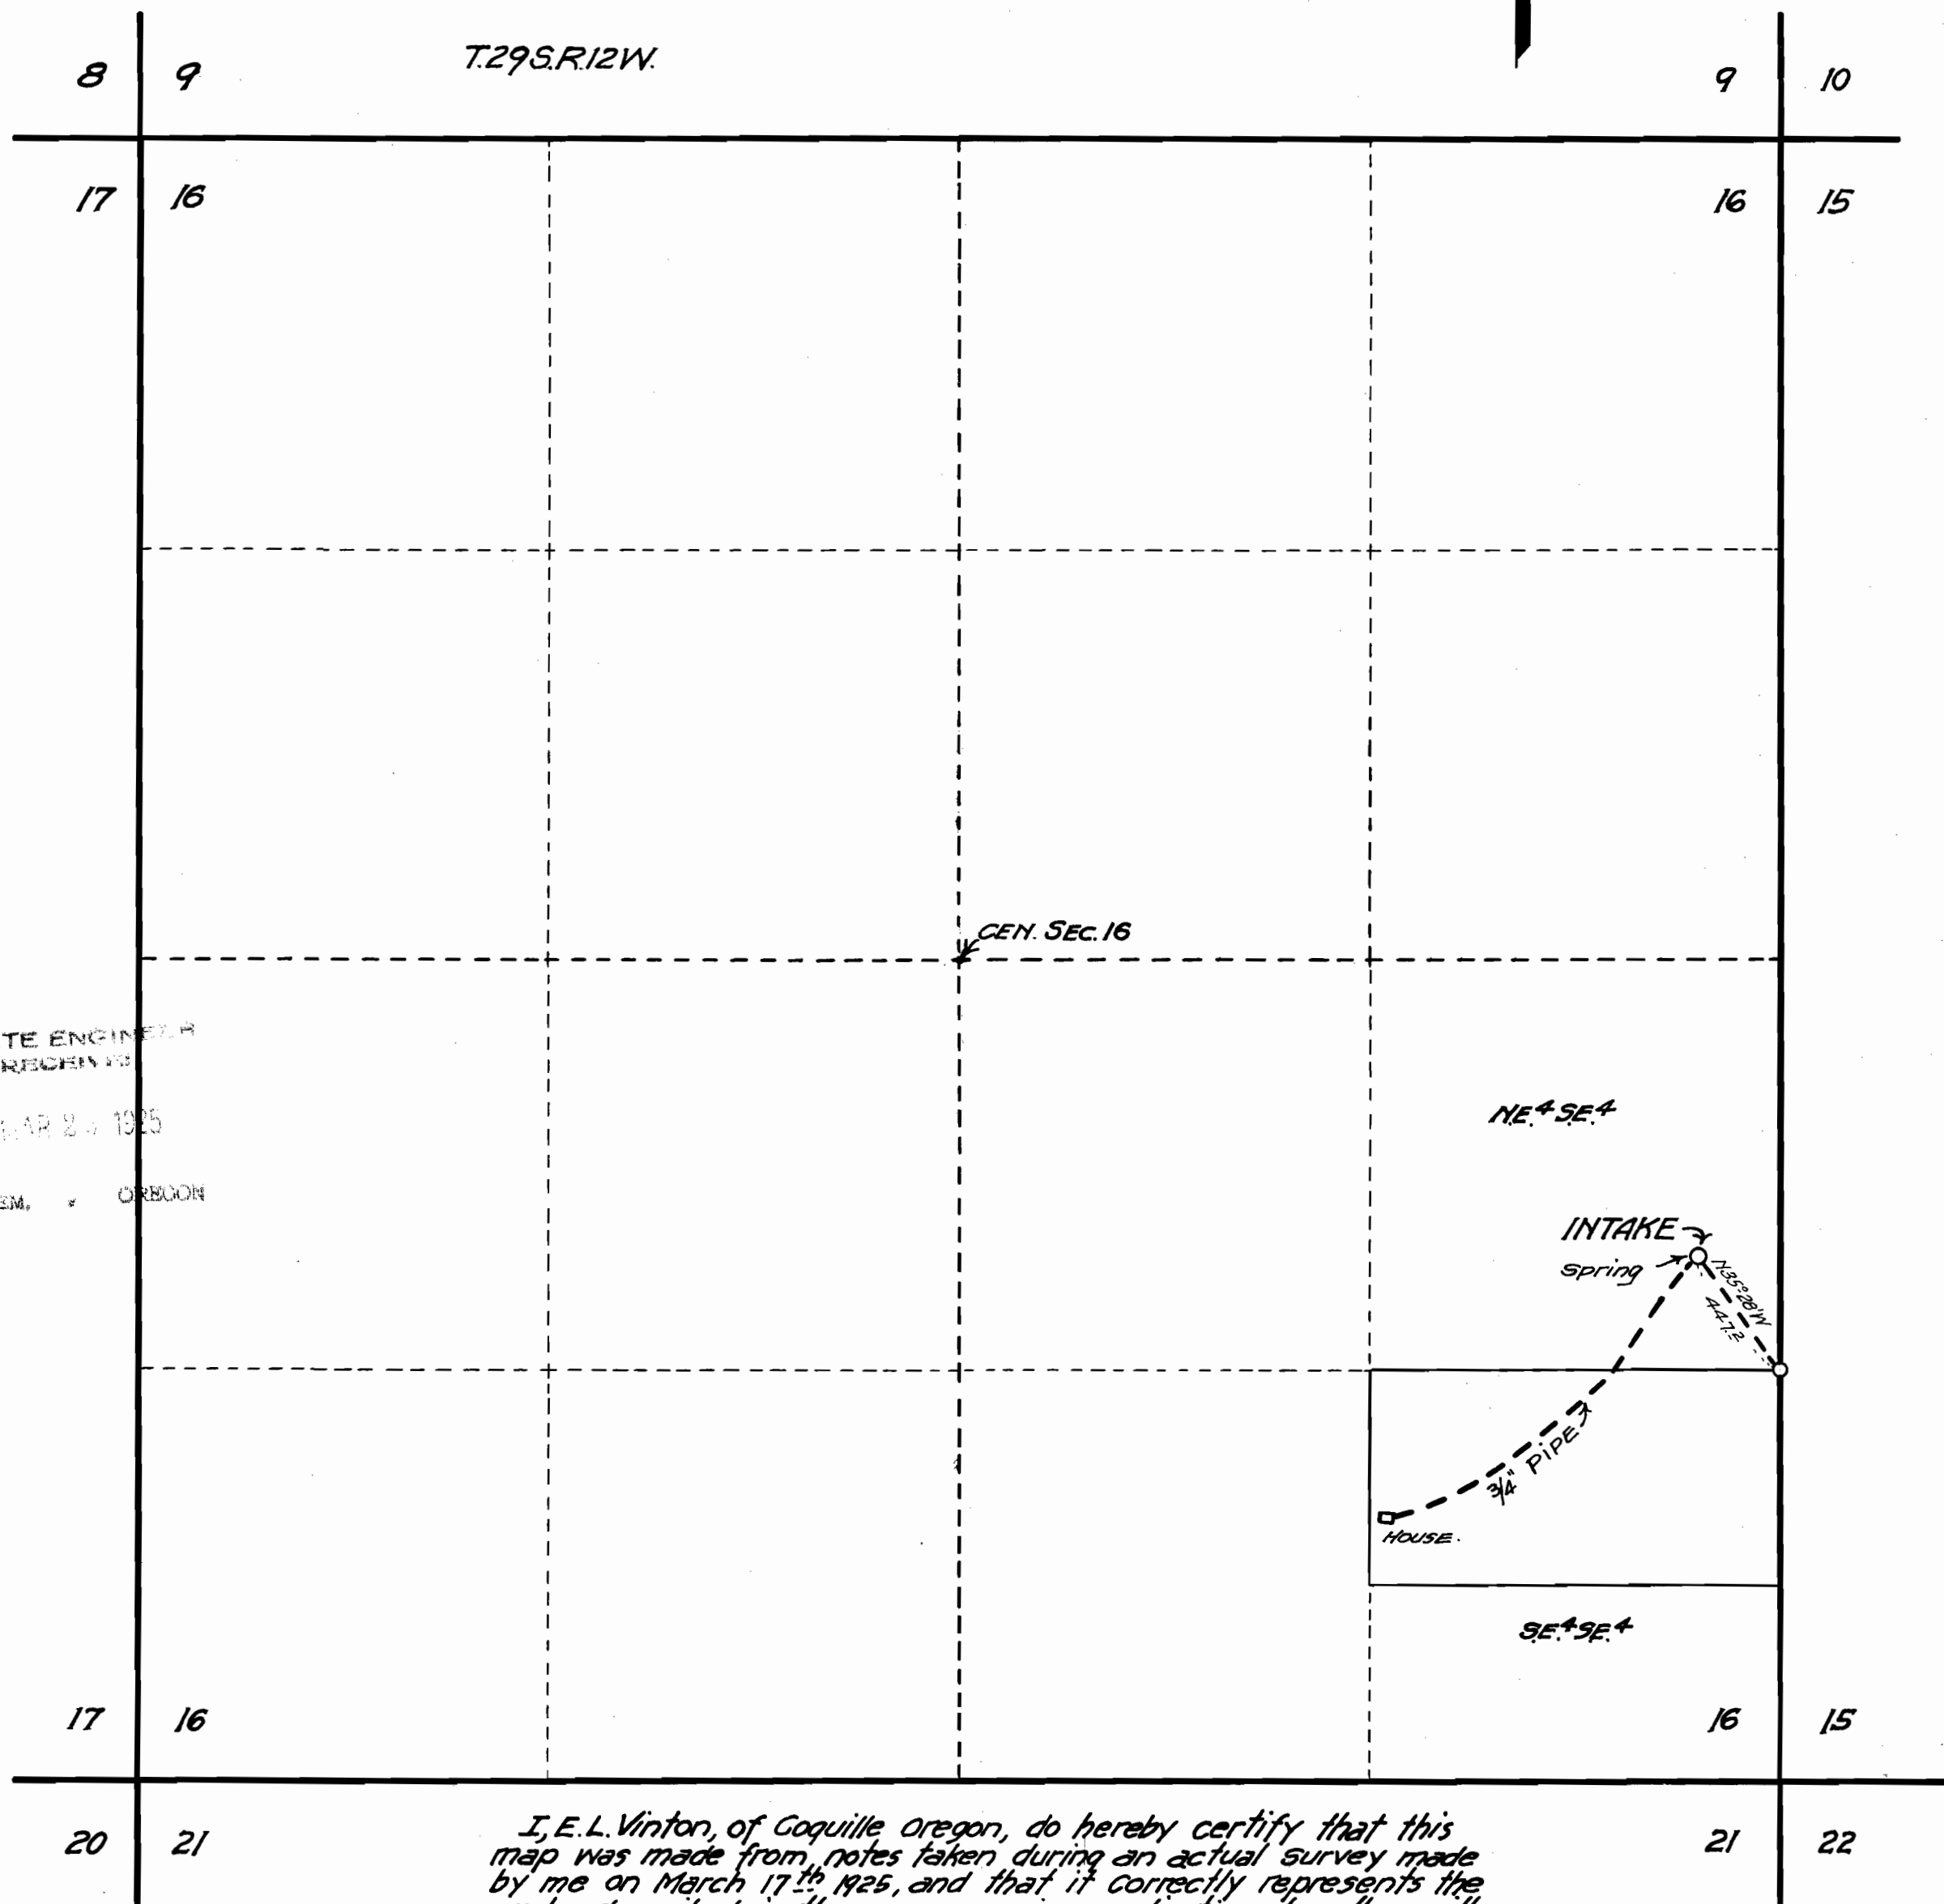

STATE ENGINEER
 RECEIVED

MAR 24 1925

SALEM, OREGON

I, E.L. Vinton, of Coquille Oregon, do hereby certify that this map was made from notes taken during an actual survey made by me on March 17th 1925, and that it correctly represents the works described in the accompanying application, together with the location of streams and other ditches in the immediate vicinity

Oregon No 164
 Date of registration Nov. 8-1919

E.L. Vinton
 Registered Professional Engineer.

App. 10059
 Permit No. 6711

Application No. 10059
 Permit No. 6711