


RECEIVED


SEP 19 1995

WATER RESOURCES DEPT  
SALEM OREGON

# T.6S., R.6&7W., W.M.

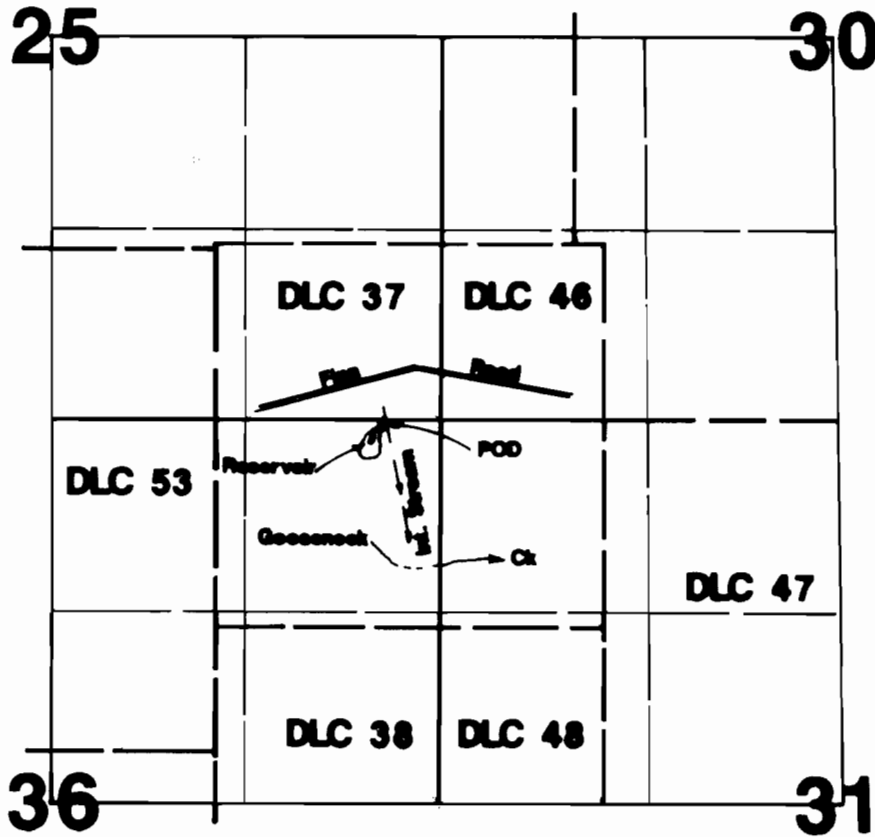

POD located 50'S & 400'W from NE corner Section 36.

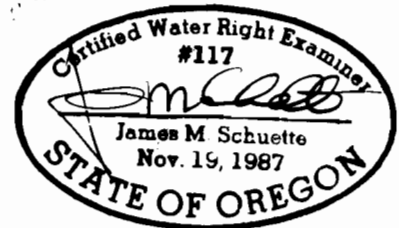

## Final Proof Survey

Application #: R-71746    Permit #: R-11405

In Name Of

# Walton & Esther James

Surveyed on August 26, 1995 by JM Schuette

THIS MAP WAS PREPARED FOR THE PURPOSE OF IDENTIFYING THE LOCATION OF A WATER RIGHT ONLY AND IS NOT INTENDED TO PROVIDE LEGAL DIMENSIONS OR LOCATION OF PROPERTY OWNERSHIP LINES.