

SECTION 28, T.3N., R.3W., W.M.

SE 1/4 NW 1/4


SW 1/4 NE 1/4



RECEIVED

SEP 3 1995

WATER RESOURCES DEPT.
SALEM, OREGON

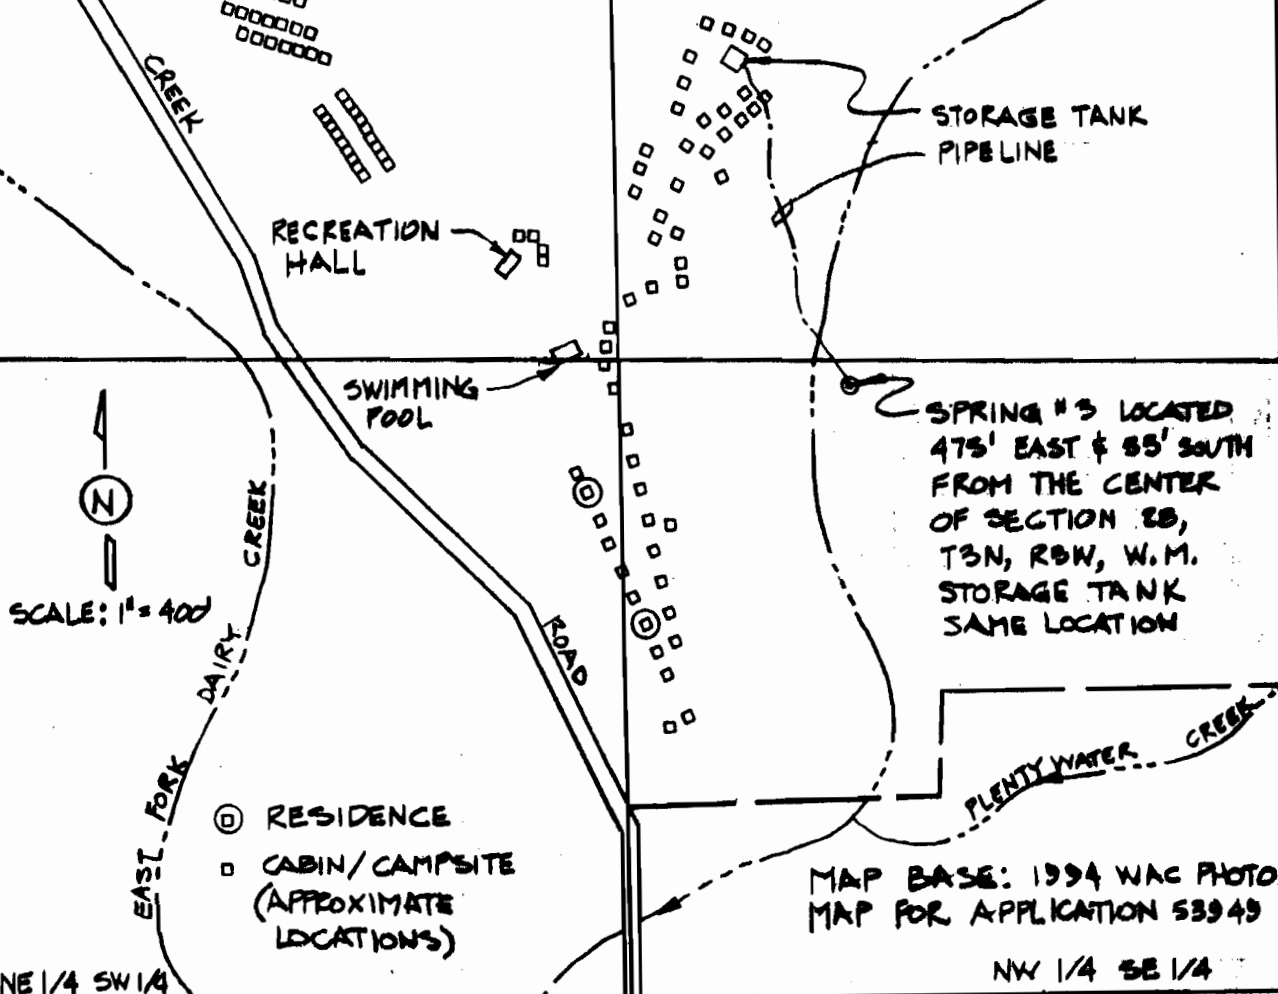

MAP BASE: 1994 WAC PHOTO
MAP FOR APPLICATION 53949

FINAL PROOF SURVEY
UNDER
APPLICATION-70MB PERMIT-SIERG
SURVEYED AUGUST 30, 1995

PREPARATION OF THIS MAP IS FOR THE
PURPOSE OF IDENTIFYING THE LOCATION OF
THE WATER RIGHT ONLY. THERE IS NO INTENT
TO PROVIDE DIMENSIONS OR LOCATION OF
PROPERTY OWNERSHIP LINES.

VERBOORT ENGINEERING
AGRICULTURE • CIVIL • WATER RESOURCES
HILLSBORO, OREGON

by date
designed WRV 8.95
drawn JER 8.95
checked WRV 8.95
drawing no. 95-A-11
sheet no. 1/1

RESTFUL HAVEN HEALTH CLUB INC
6457 S.W. 132ND
ALOHA, OR 97007