SUPERSEDING

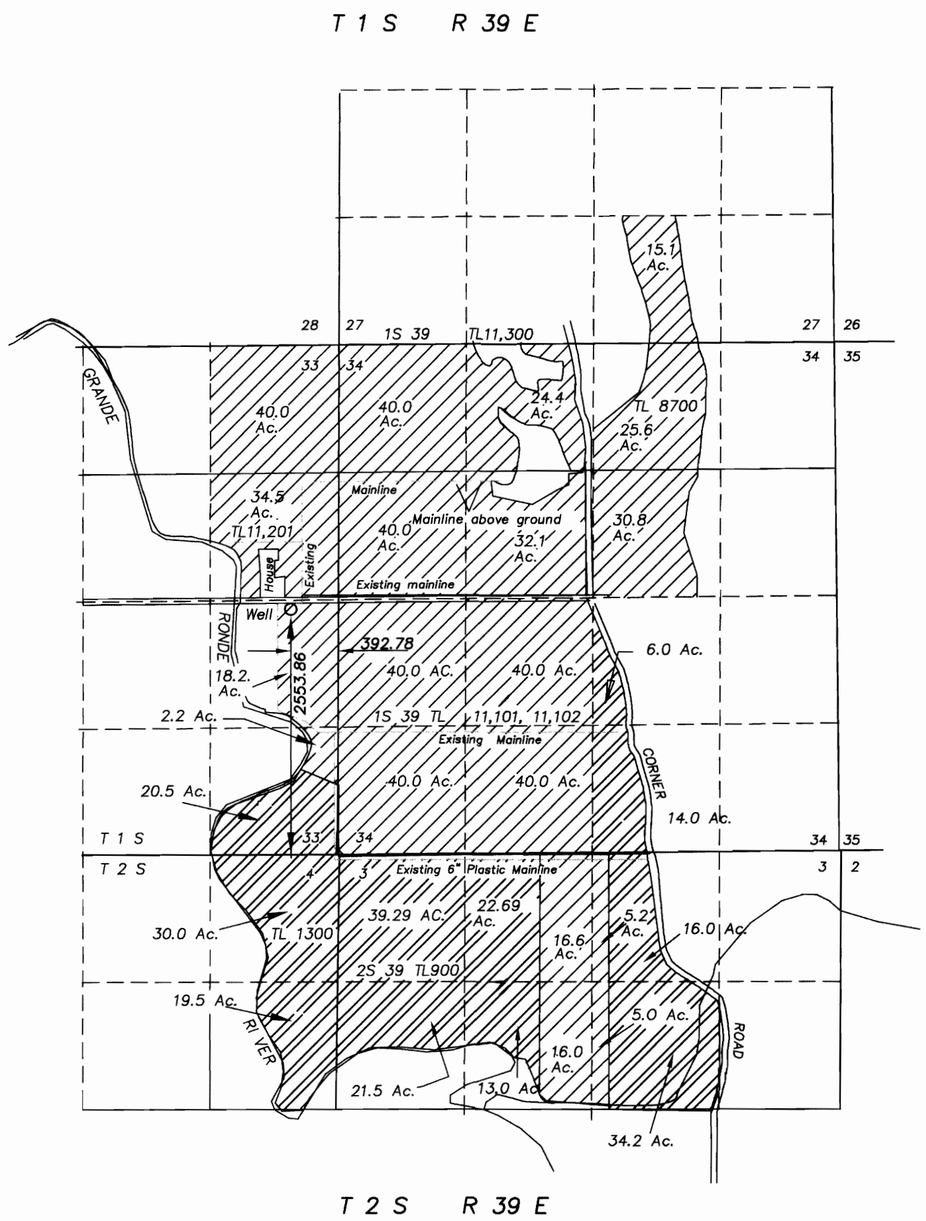

SCALE: 1"=1320'

LANDS WITH SUPPLEMENTAL RIGHTS FROM NEW WELL.

LANDS WITH PRIMARY RIGHTS FROM NEW WELL.

Certified Water Right Examiner
021
Gregory T. Blackman
Nov. 19, 1987
STATE OF OREGON

NOTE: The preparation of this map was for the purpose of identifying the location of the proposed water right and has no intent to provide dimensions or location of property ownership lines. Location information shown hereon was furnished by the applicant.

SUPERSEDING

FINAL PROOF MAP FOR

WATER RIGHTS
FOR
RUSSELL H. BINGAMAN &
PATRICIA LYNN BINGAMAN
BY
BAGETT – GRIFFITH & ASSOCIATES
2006 ADAMS AVENUE
LAGRANDE, OREGON 97850

NOVEMBER 29, 2007

APPLICATION NO. G-13407

PERMIT NUMBER G-12382

COBU MAP # 0333