


T. 38 S., R. 7 W., W. M.

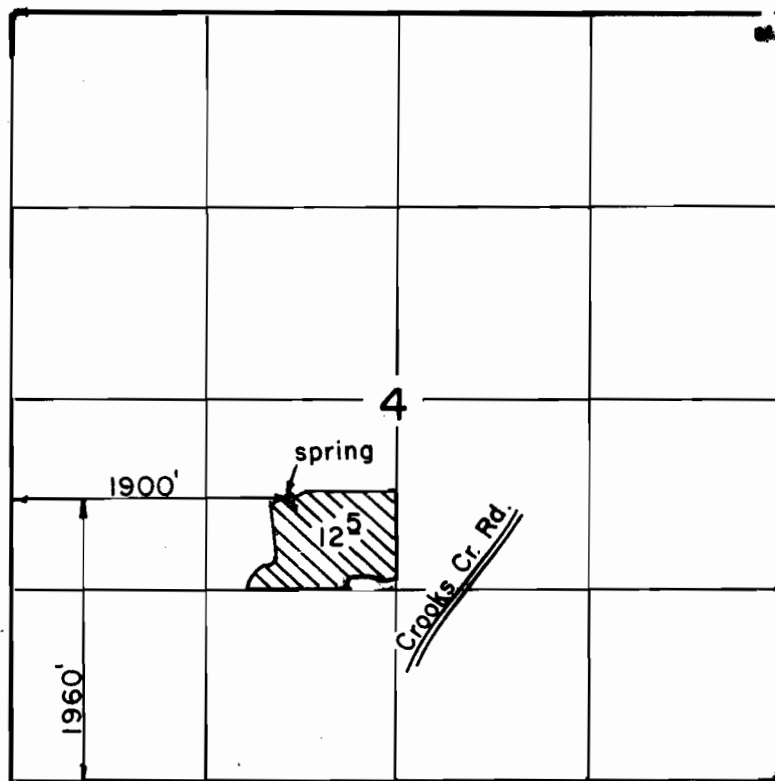

Scale: 1" = 1320'

FINAL PROOF SURVEY
UNDER

Application No. ~~64998~~ Permit No. ~~47561~~....
IN NAME OF

.....
Surveyed N.O.V...5. 1991., by B...S...JAMES....

205/172