

6825

8422

Appd. 10260

N

TRENTING FLAT.

Project Area Sec 17-T40SR4 E. Will. Mer

Camp No. _____

Date June 27, 1925 Compassman _____T. 40S. R. 4E. Sec. 17

Legend-

 Under irrigation now

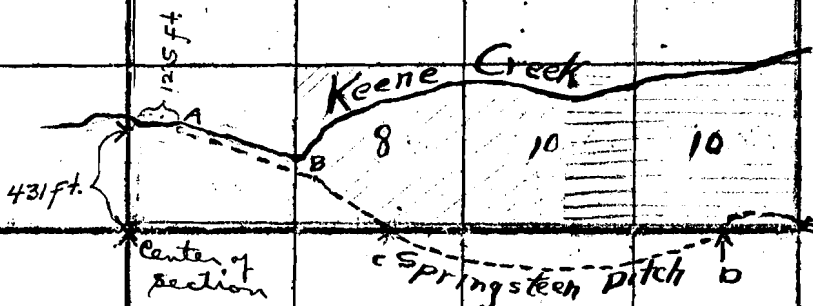
 To be irrigated

A to B - 540 ft.

A to C - 873 ft.

C to D - 1325 ft.

D to E - 270 ft.

STATE ENGINEER
RECEIVED

JUL 1 1925

Application No. 10260

Permit No. 6825

SALEM.

OREGON

REMARKS: _____

S