


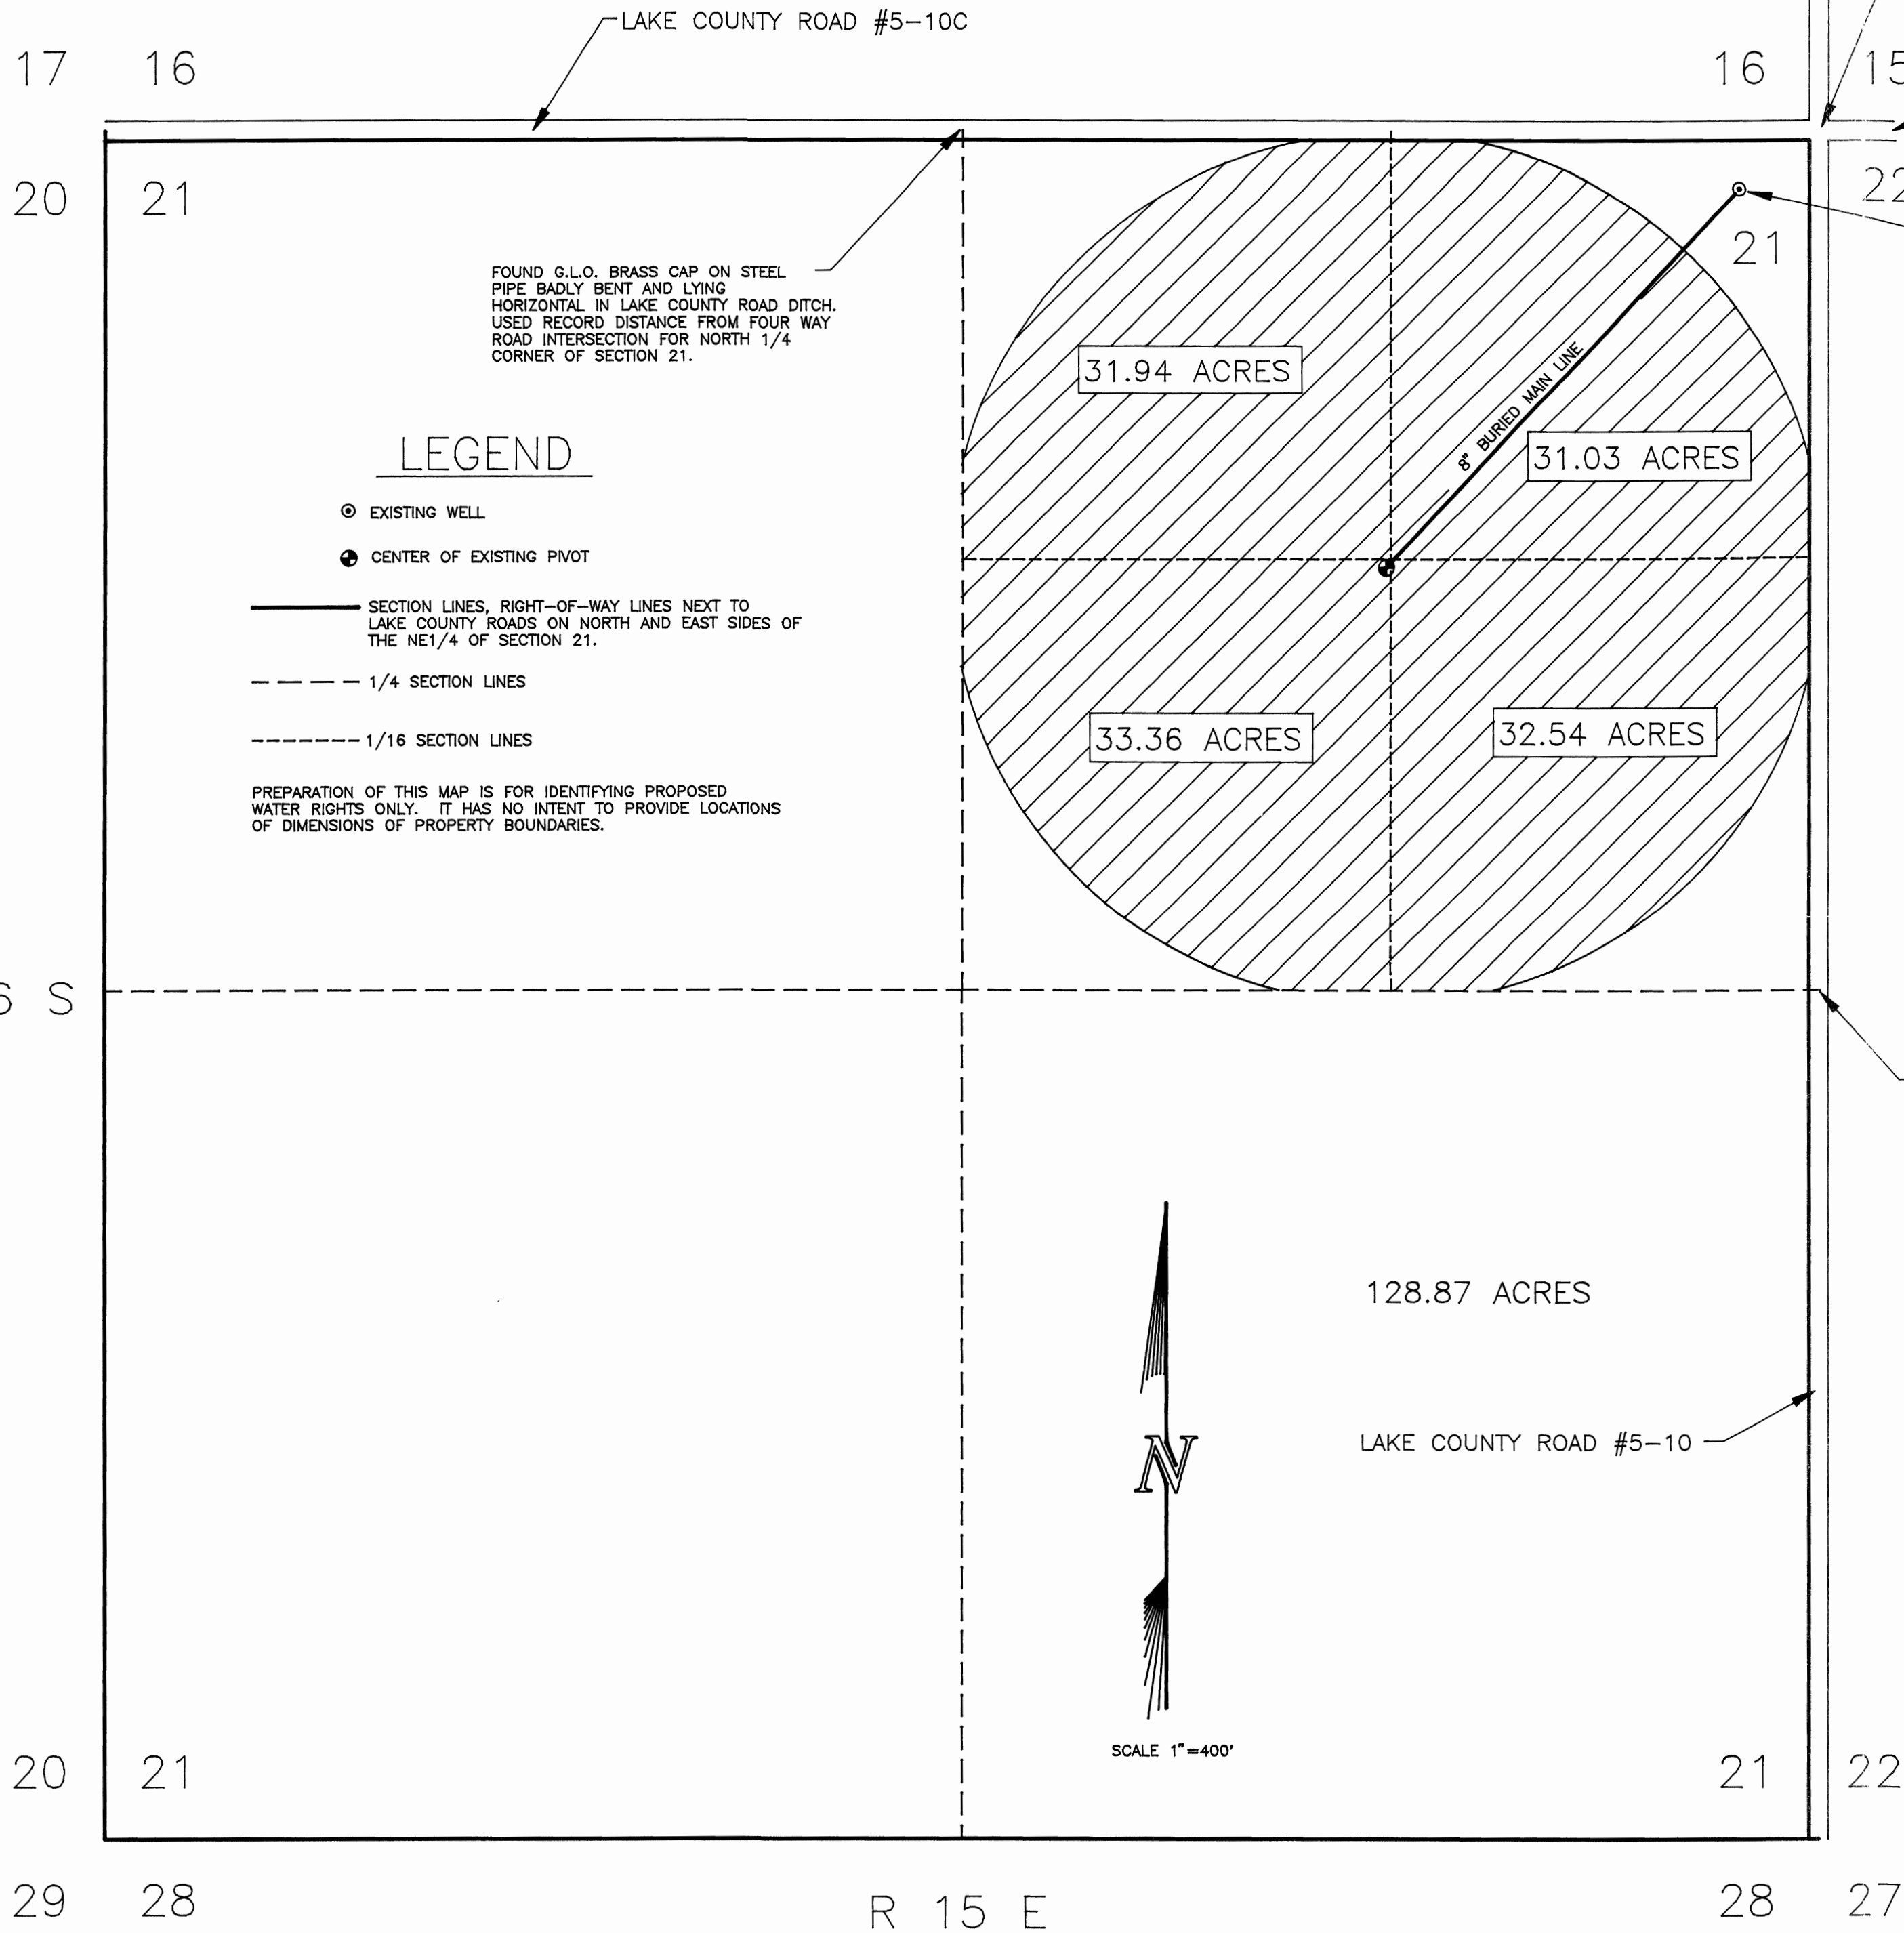

LEGEND

- ⊙ EXISTING WELL
 - ⊙ CENTER OF EXISTING PIVOT
 - SECTION LINES, RIGHT-OF-WAY LINES NEXT TO LAKE COUNTY ROADS ON NORTH AND EAST SIDES OF THE NE1/4 OF SECTION 21.
 - - - 1/4 SECTION LINES
 - - - - 1/16 SECTION LINES
- PREPARATION OF THIS MAP IS FOR IDENTIFYING PROPOSED WATER RIGHTS ONLY. IT HAS NO INTENT TO PROVIDE LOCATIONS OF DIMENSIONS OF PROPERTY BOUNDARIES.

FINAL PROOF SURVEY
FOR
ALBERT A. GOUPIL
STAR ROUTE
SILVER LAKE, OR 97638
(541)576-2565

LOCATED IN THE NE 1/4 OF SECTION 21
TOWNSHIP 26 SOUTH, RANGE 15 EAST, W.M.
LAKE COUNTY, OREGON


APPLICATION NO.: G-11232
PERMIT NO.: G-13113

TIED CENTER OF LAKE COUNTY ROAD AND
EXTENSION OF EAST-WEST FENCES ON BOTH
SIDES OF THE ROAD AS EAST 1/4 CORNER
OF SECTION 21.

RECEIVED

MAY 20 1997

WATER RESOURCES DEPT
SALEM, OREGON

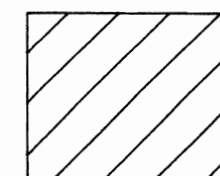

128.87 ACRES IN THE NORTHEAST ONE QUARTER
OF SECTION 21.



RENEWAL 12/31/97

PREPARED FOR:
ALBERT A. GOUPIL
STAR ROUTE
SILVER LAKE, OR 97638
(541) 576-2565

PREPARED BY:
ANDERSON ENGINEERING & SURVEYING, INC.
P.O. BOX 28 LAKEVIEW, OREGON 97630 P.O. BOX 419 REDMOND, OREGON 97756
(541) 947-4407 (541) 923-4307
FAX 947-2321 FAX 923-4308

DATE: 4/18/97 DWG. FILE: 97048
JOB NO.: 97048 SHEET 1 OF 1

JBU MAP # 0014