


T.9S. R.2W., W.M.

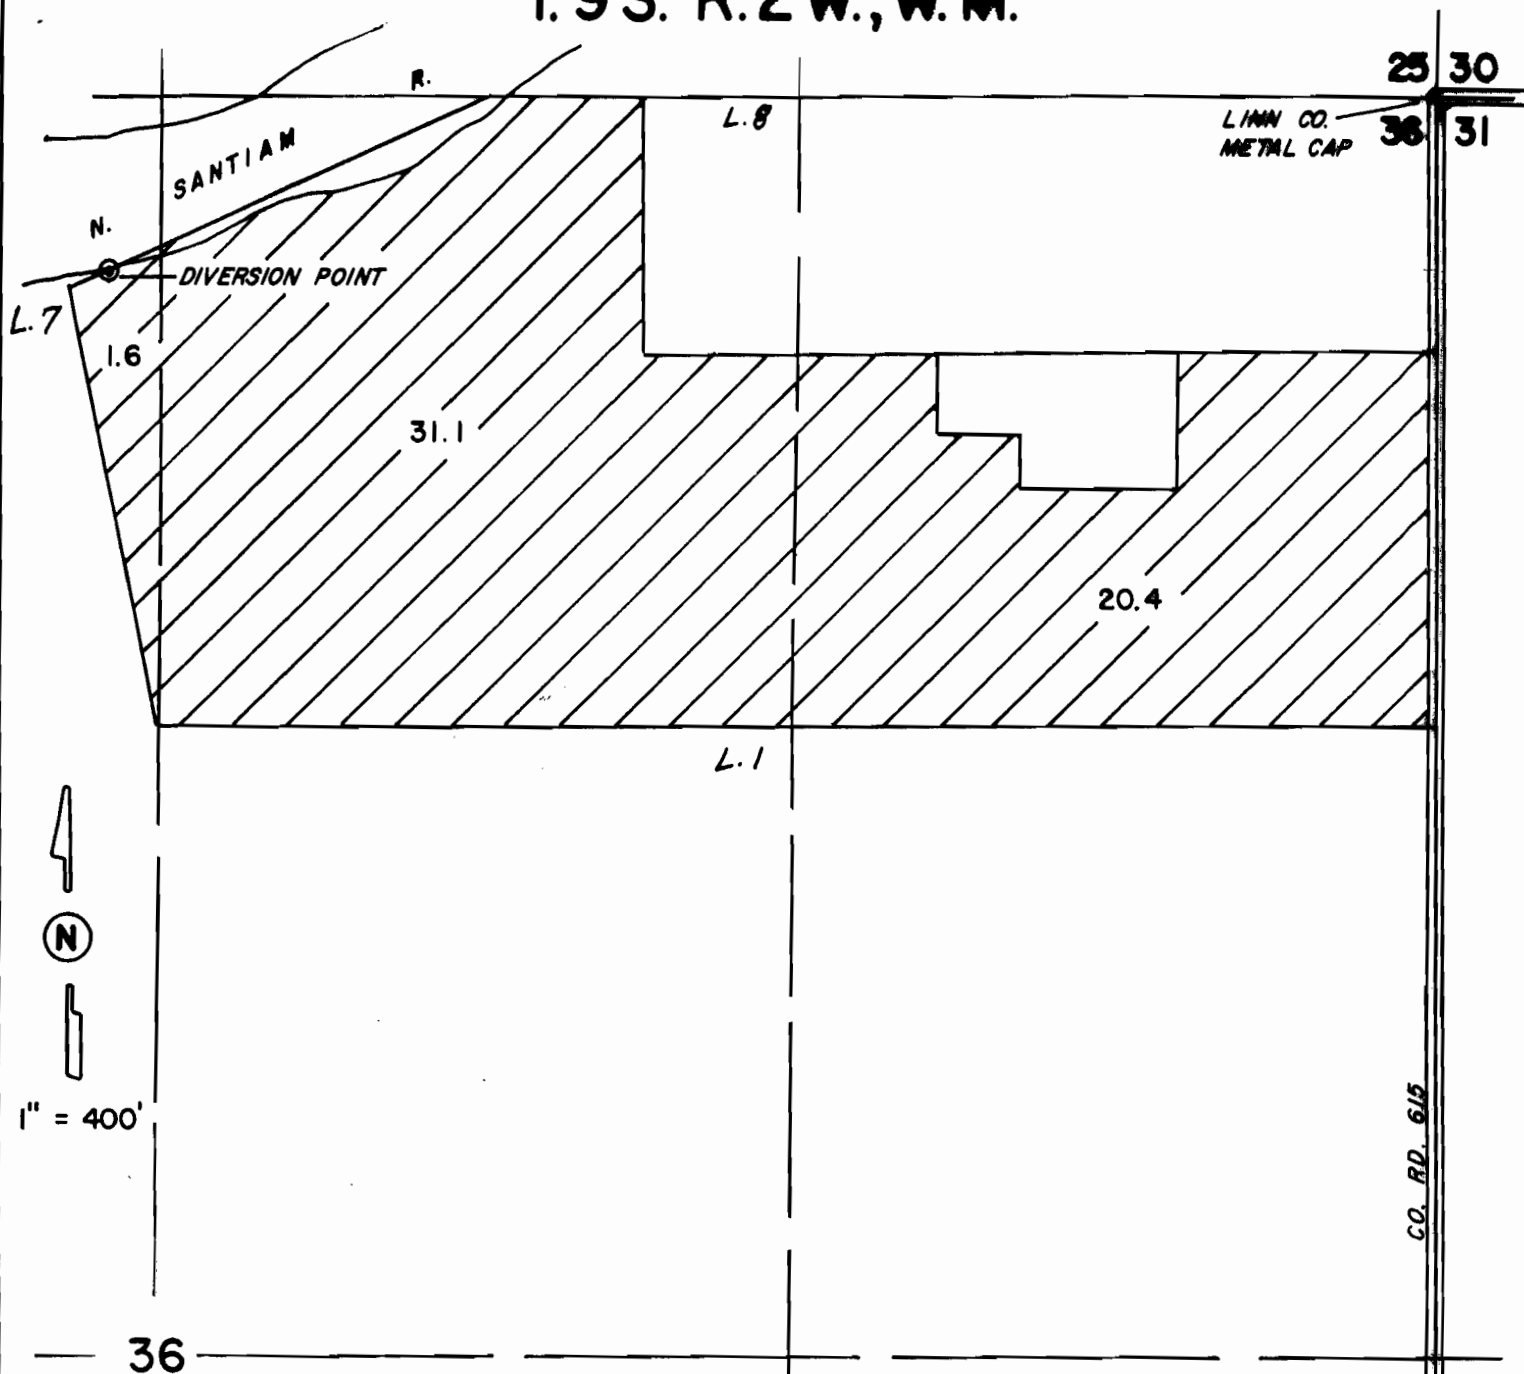

LINN CO. METAL CAP

25 30
36 31



1" = 400'

CO. RD. 615

36

DIV. PT. LOC. 370' S. & 2765' W. FROM N.E. CORNER, SEC. 36

FINAL PROOF SURVEY

FOR

JOHN STOLK

SURVEYED ON JUNE 22, 1994

THIS MAP WAS PREPARED FOR THE PURPOSE OF IDENTIFYING THE LOCATION OF A WATER RIGHT ONLY AND IS NOT INTENDED TO PROVIDE LEGAL DIMENSIONS OR LOCATION OF PROPERTY OWNERSHIP LINES.

