



NE 1/4 NE 1/4 SEC. 36 T. 7 S. R. 3 W., W.M. w/m DLC 78

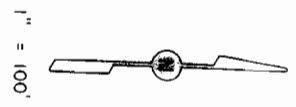

E HAWTHORNE AVE

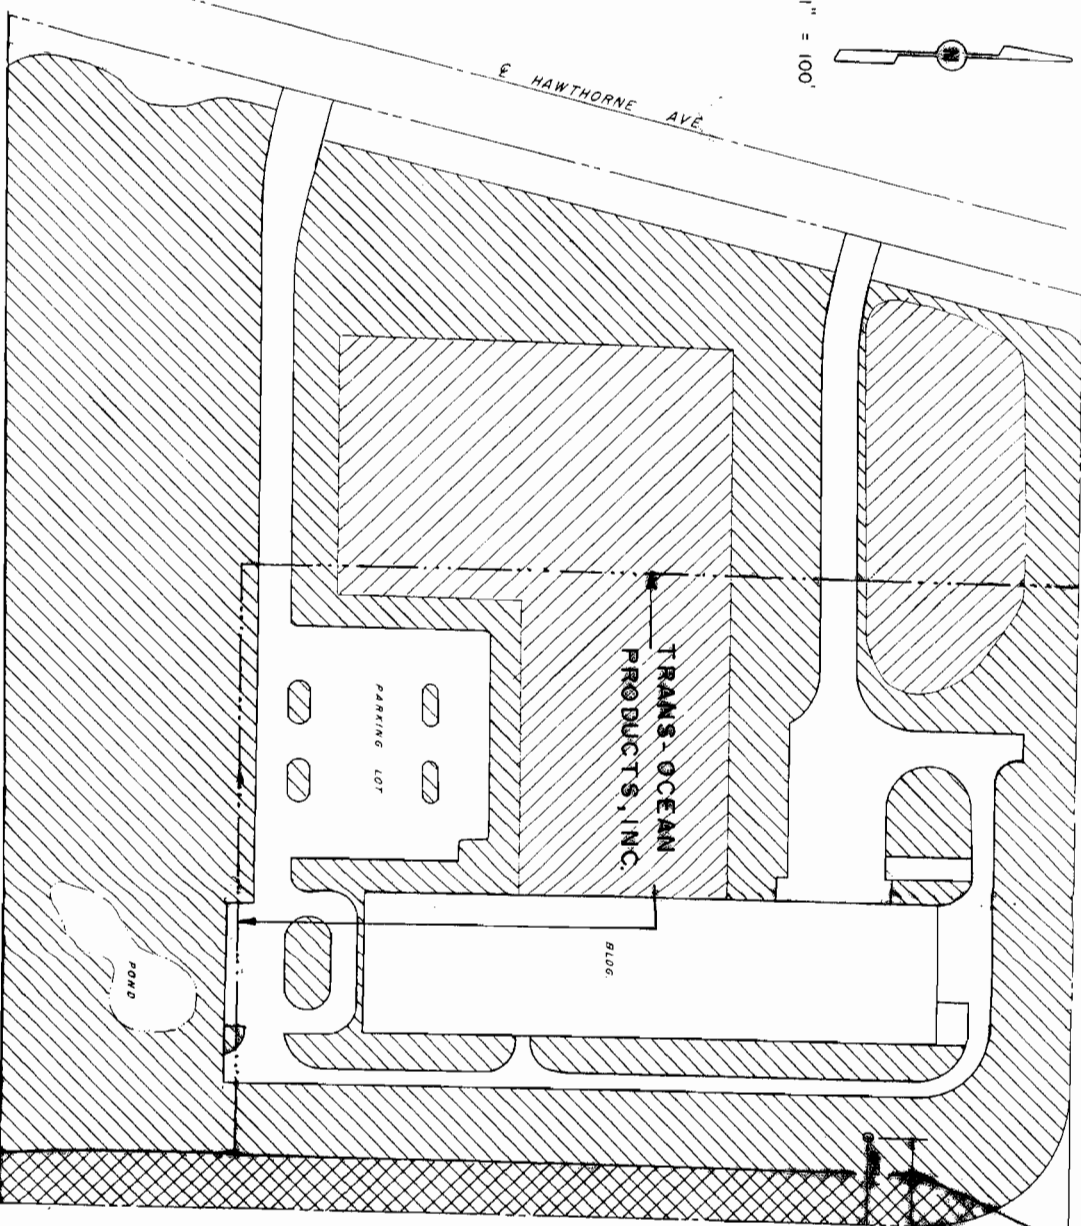

WELL LOC.: 2950' N. B. 140' W. FROM NW COR. B MUNKERS DLC NO. 39, NE COR. J.E. PARROTT DLC NO. 49

26	30
36	31
160' ±	

LEGEND

- PERMIT NO. G-11421 5.9 AC. 2.36 AC. MGA TPI
- PERMIT NO. G-12216 2.1 AC. 1.45 AC.
- PERMIT NO. G-11421 0.8 AC. LOST TO O.D.O.T. / 1-5



FINAL PROOF SURVEY UNDER

KYOTARU OF AMERICA
 (AMENDMENT TO APPL. G-12230 PER. G-11421)
 Application No. G-13527 Permit No. G-12216.
 IN NAME OF

ADDED NW 1/4 DLC W/D - LHM 3/24/08
 INSPECTED ON AUGUST 7, 2000
 INSPECTED ON AUGUST 6, 1993
 SURVEYED ON AUGUST 13, 1990

BY:



NW CORNER
 B MUNKERS
 DLC NO. 39
 NE CORNER
 J.E. PARROTT
 DLC NO. 49

THIS MAP WAS PREPARED FOR THE
 PURPOSE OF A FINAL SURVEY AND IS
 NOT INTENDED TO BE USED FOR ANY
 OTHER PURPOSE WITHOUT THE WRITTEN
 CONSENT OF THE SURVEYOR.