



NE 1/4 NE 1/4 SEC. 36 T. 7 S. R. 3 W., W.M. w/m DLC 78

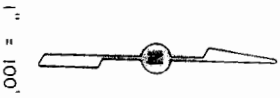

E HAWTHORNE AVE

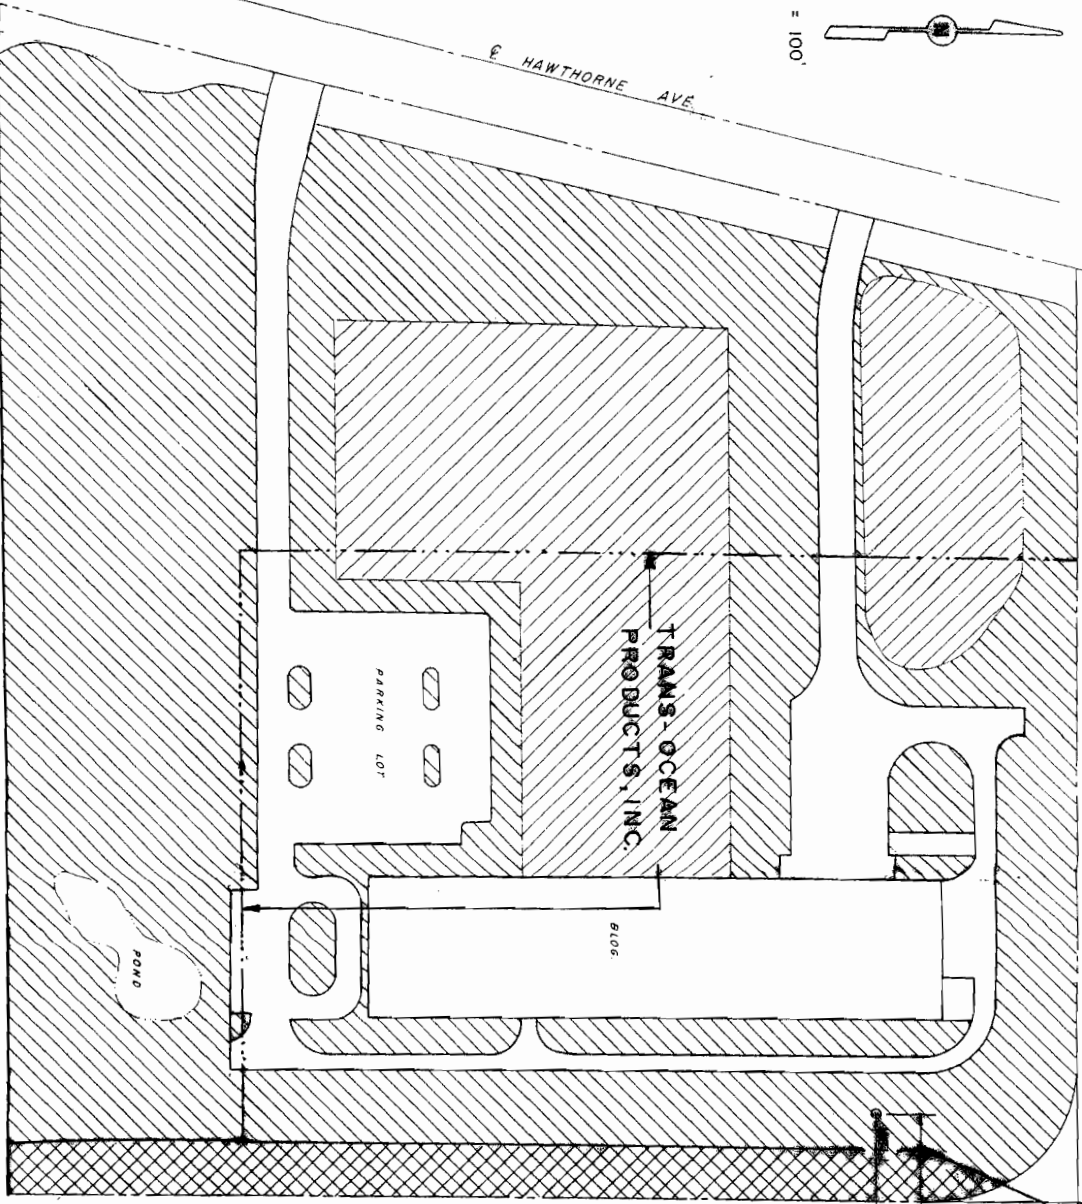

WELL LOC. 2950' N. 8 140' W. FROM NW COR. B MUNKERS DLC NO. 39 ; NE COR. J.E. PARROTT DLC NO. 49

25	30
36	31
150' ±	

LEGEND

- PERMIT NO. G-11421 5.8 AC. 2.85 AC.
- PERMIT NO. G-12216 2.1 AC. 1.45 AC.
- PERMIT NO. G-11421 0.8 AC.
- LOST TO O.D.O.T. / 1-5



SOURCE:
L.M. OR

FINAL PROOF SURVEY
UNDER

(AMENDMENT TO APPL. G-12230 PER. G-11421)
Application No. G-1359.7 Permit No. G-12216..
IN NAME OF

KYOTARU OF AMERICA

ADDED W-1/4 DLC WRD-LAN 3/24/68
INSPECTED ON AUGUST 7, 2000
INSPECTED ON AUGUST 6, 1993
SURVEYED ON AUGUST 13, 1990

BY:



NW CORNER
B. MUNKERS
DLC NO. 39
NE CORNER
J.E. PARROTT
DLC NO. 49

