
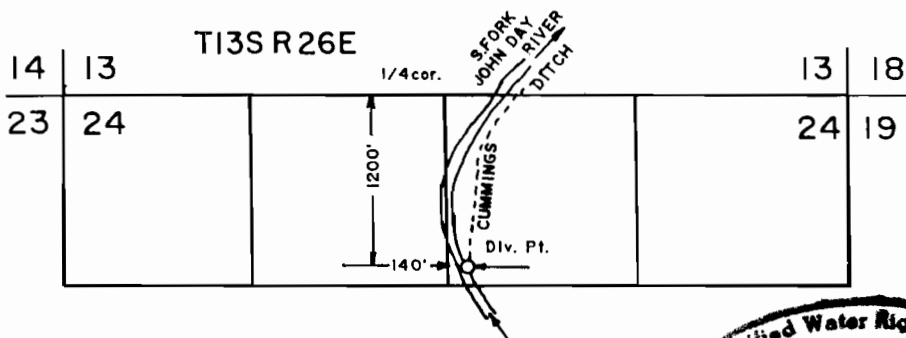


T13S, R26 & 27E, W.M.

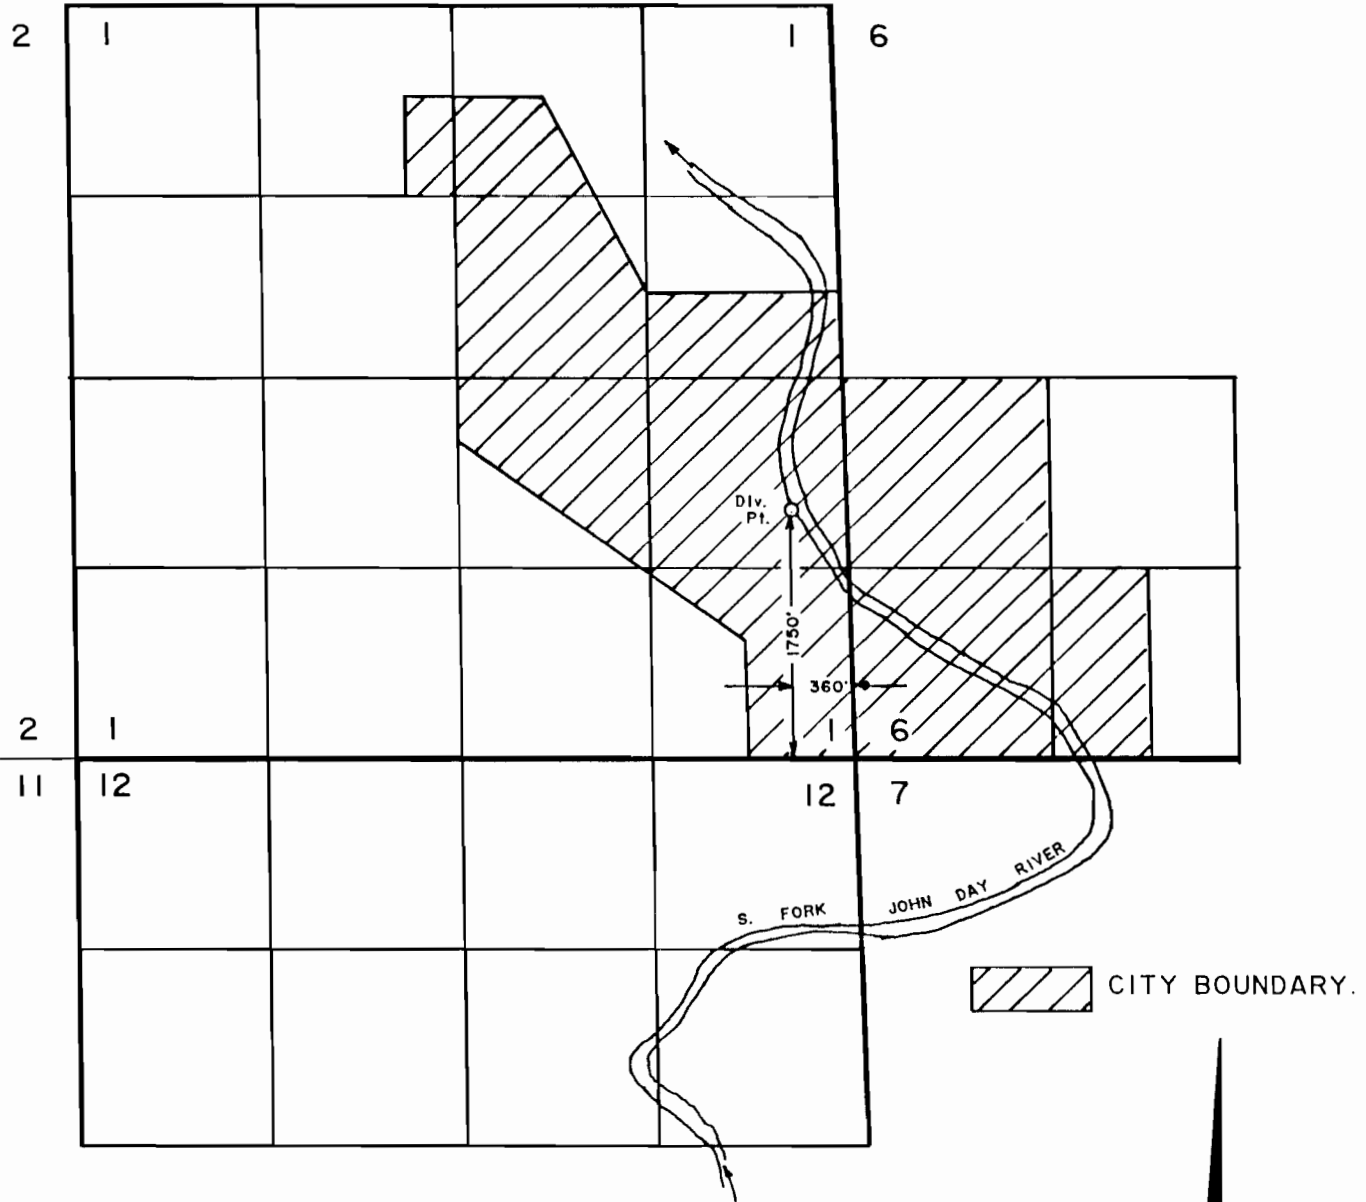

FINAL PROOF SURVEY
UNDER

TRANSFER NO. T-6317
IN NAME OF
CITY OF DAYVILLE

SURVEYED FEB. 21, 1991 BY *Robert D. Baggett*

