


T.5N., R.27E., W.M.

COLUMBIA RIVER

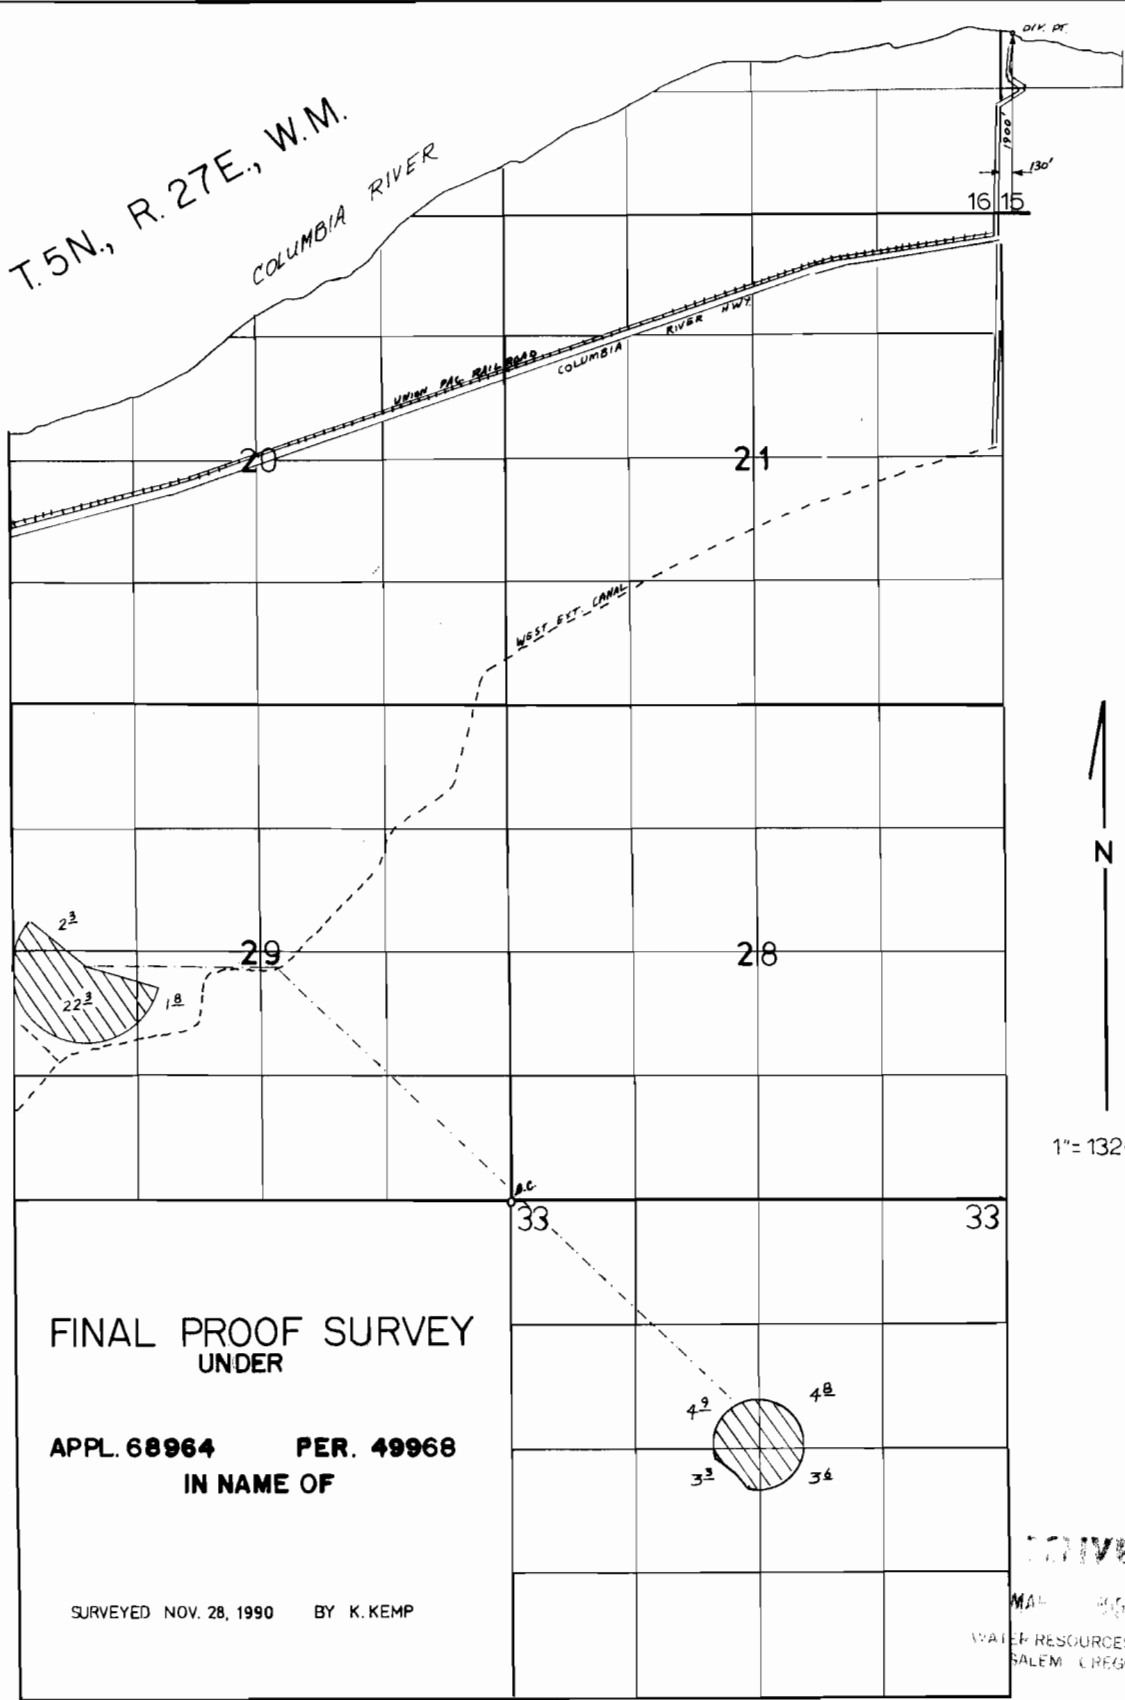

FINAL PROOF SURVEY  
UNDER

APPL. 68964 PER. 49968  
IN NAME OF

SURVEYED NOV. 28, 1990 BY K. KEMP

MAILED  
WATER RESOURCES DEPT  
SALEM, OREGON