



T23S, R7W, WM

DOUGLAS COUNTY


SCALE 1" = 40'

SHEET 2 OF 2

FINAL PROOF SURVEY

Application No. R-72666 Permit No. R-11514

HUDSON K. OR JEAN SHERLOCK

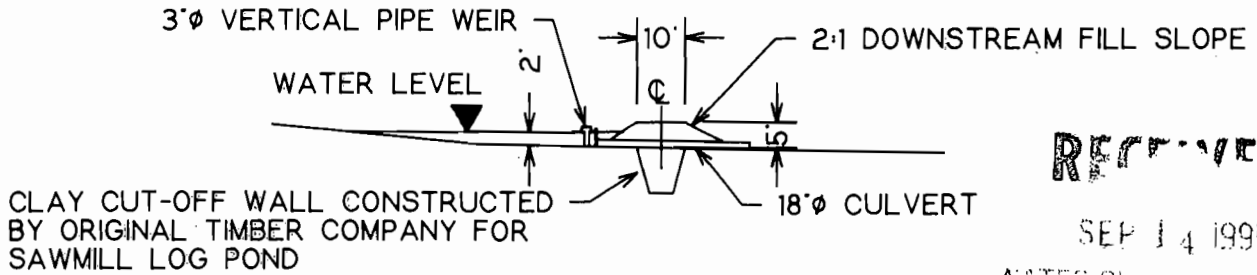


DAM PROFILE

RECEIVED

SEP 14 1995

WATER RESOURCES DEPT  
SALEM, OREGON

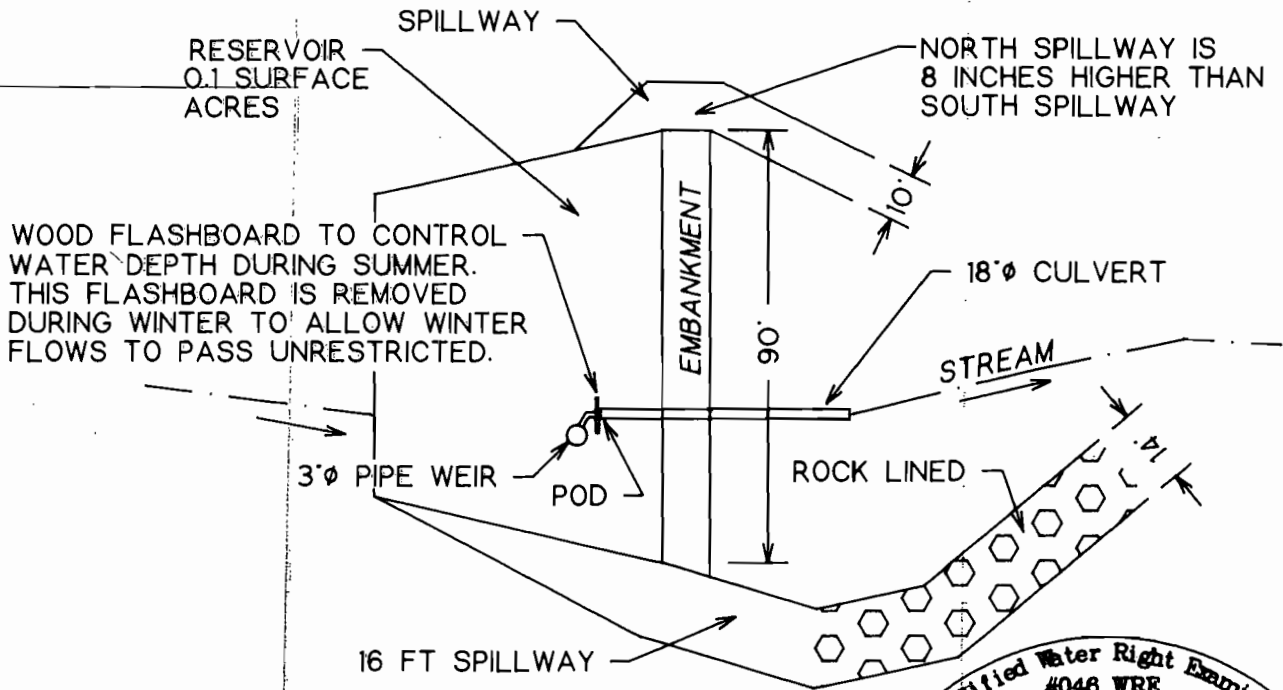

RESERVOIR PLAN

Certified Water Right Examiner  
#048 WRE  
*Maurice E. Farr*  
Maurice E. Farr  
Nov. 19, 1987  
STATE OF OREGON

9-95

EXPIRES 12-31-95