

35

SIUSLAW RIVER

GOVERNMENT LOT 6
(NW 1/4 SW 1/4)

GOVERNMENT LOT 5
(NE 1/4 SW 1/4)

POINT OF DIVERSION IS
NORTH 1019 FEET AND
EAST 959 FEET FROM
THE SW CORNER OF
SECTION 35.

METER IS LOCATED IN PUMP HOUSE
NORTH 5 FEET AND WEST 36 FEET
FROM THE POD.

FISH SCREEN IS AT POD.

AREA IRRIGATED
AREA IRRIGATED IS 0.37 AC

THIS MAP IS FOR THE PURPOSE
OF IDENTIFYING THE LOCATION
OF THE WATER RIGHT ONLY.
THERE IS NO INTENT TO PROVIDE
DIMENSIONS OR LOCATION OF
PROPERTY OWNERSHIP LINES.

COLTER STREET

EAST 959



SW 1/4 SW 1/4

SE 1/4 SW 1/4

NORTH 1019

34 35 BRASS CAP

3 2

COBU MAP # 0325

FINAL PROOF SURVEY
CLAIM OF BENEFICIAL USE
WATER RIGHTS MAP
MID COAST BASIN
UNDER
PERMIT 54262
APPLICATION NO S-86419

RECEIVED

JUN 11 2008


WATER RESOURCES DEPT
SALEM, OREGON

18-12-35-3-3, T.L. 900
SW 1/4, SW 1/4, SEC 35, T18S, R12W, W.M.
LANE COUNTY, OREGON

FOR: STEVEN K. AND REBECCA S. WILLIAMS
2107 HWY 101, PMB 161
FLORENCE, OREGON 97439

PREPARED BY: WOBBE & ASSOCIATES, INC.
510 KINGWOOD ST. / P.O. BOX 3093
FLORENCE, OR 97439

DATE: FEBRUARY 7, 2008
Rev. June 9, 2008

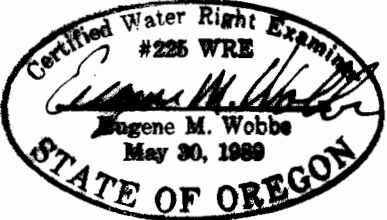

1"=400'