


T 21 S, R 32 1/2 E, WM

RECEIVED

SEP 21 1999

WATER RESOURCES DEPT.
SALEM, OREGON

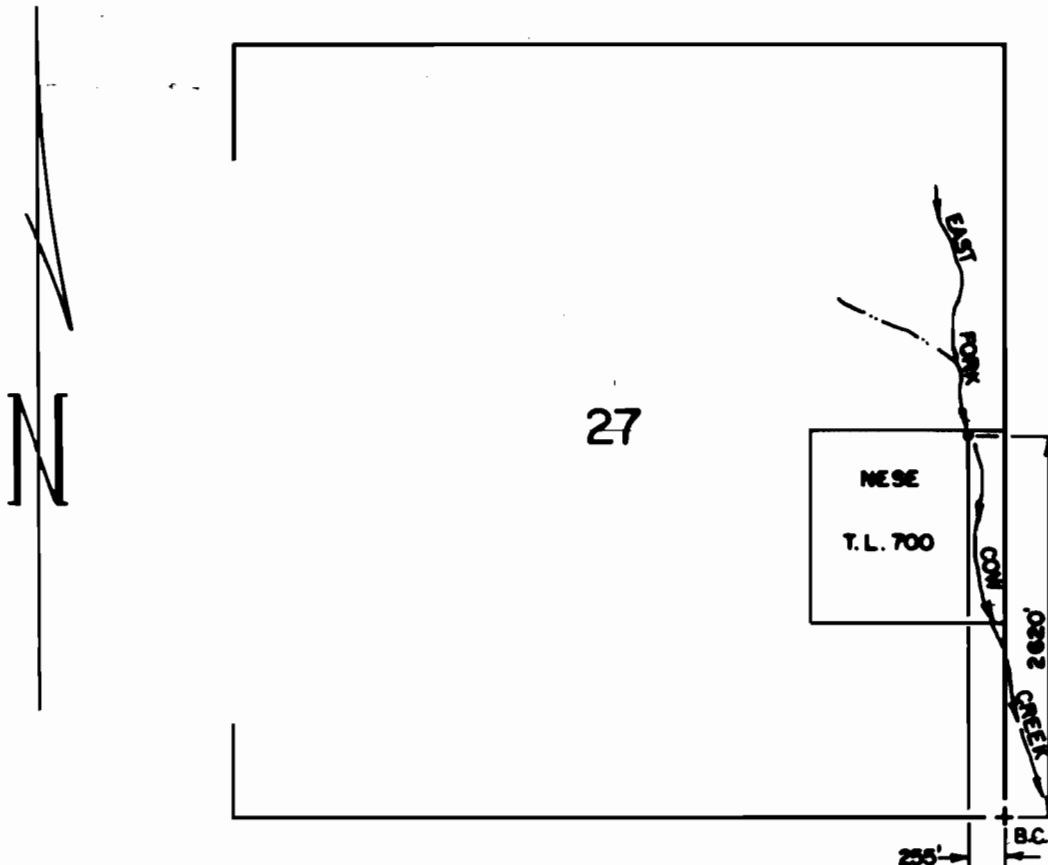

THE PURPOSE OF THIS MAP IS TO
IDENTIFY THE LOCATION OF THE
WATER RIGHT. IT IS NOT INTENDED
TO PROVIDE INFORMATION RELATIVE
TO THE LOCATION OF PROPERTY
OWNERSHIP.

 Chris T. Palmer Nov. 19, 1987 STATE OF OREGON RENEW 1-1-2001	FINAL PROOF SURVEY		
	UNDER APPLICATION NO. 72196 PERMIT NO. 52822		IN THE NAME OF JACK G. & BONNIE J. SMITH
	Scale: 4" = 1 MILE	Date: 08-15-1999	Job: 1285-99A
	Drawn by: Dm: CHRIS	 M.A. PALMER & SONS, INC. ENGINEERING & SURVEYING 711 Ponderosa Village • Box 61 Burns, Oregon 97720	Sht. No. _____
	Ckd: _____		of _____