

CLAIM OF BENEFICIAL USE  
IN THE NAME OF  
ROBERT W. BISHOP  
DIANA D. BISHOP  
SURVEYED BY DUANE W. KIRBY

T26S, R4W, W.M.




1 INCH = 1320 FEET

RECEIVED

NOV 28 2001

WATER RESOURCES DEPT.  
SALEM, OREGON

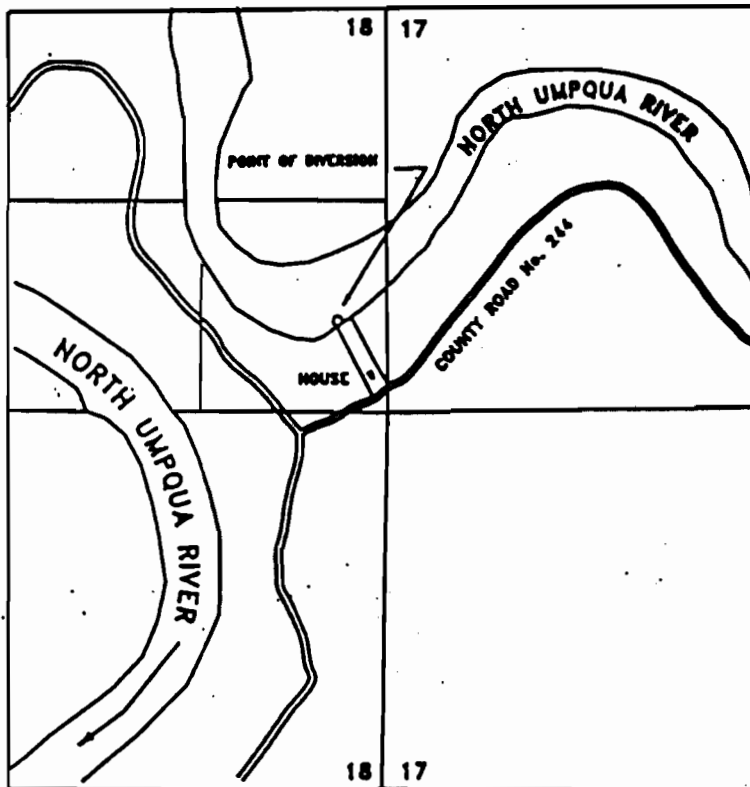

RECEIVED

SEP 27 2000

WATER RESOURCES DEPT.  
SALEM, OREGON



THE POINT OF DIVERSION IS TO BE LOCATED 575 FEET NORTH AND 100 FEET WEST FROM THE EAST 1/4 CORNER OF SECTION 18, BEING WITHIN THE SE 1/4 OF THE NE 1/4 SECTION 18, TOWNSHIP 26 SOUTH, RANGE 4 WEST, W.M.

THE PURPOSE OF THIS MAP IS TO IDENTIFY THE LOCATION OF THE WATER RIGHT. IT IS NOT INTENDED TO PROVIDE INFORMATION RELATIVE TO THE LOCATION OF PROPERTY OWNERSHIP BOUNDARY LINES.

APPLICATION S-71130

PERMIT 52213