


FINAL PROOF MAP
T26S, R3W, WM

SCALE 1' = 1320'
DOUGLAS COUNTY

RECEIVED

SEP 13 1999

WATER RESOURCES DEPT.
SALEM, OREGON

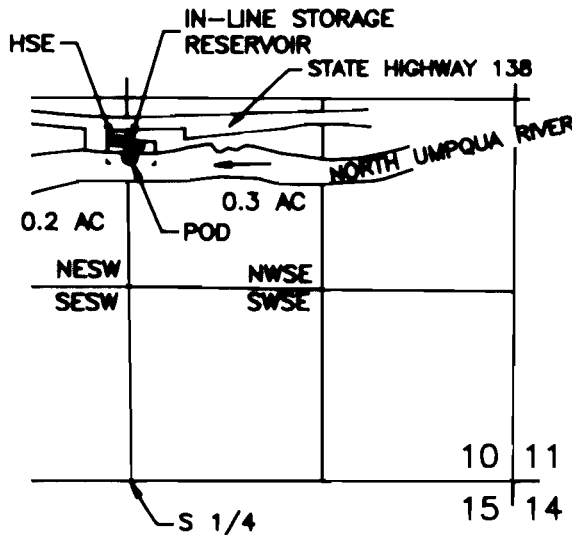

POD IS 2230 FT N AND 20 FT E FROM S 1/4 COR SEC 10

FINAL PROOF SURVEY

UNDER

Application No. S-71974 Permit No. 51787

IN NAME OF


John or Terry Holing

Surveyed July 5, 1999 by M E Farr

JOHN OR TERRY HOLING
22667 N UMPQUA HIGHWAY
GLIDE, OR 97443

THIS IS A LOCATION MAP FOR A FINAL PROOF SURVEY
BY JOHN OR TERRY HOLING. THIS MAP IS FOR THE
PURPOSE OF IDENTIFYING THE LOCATION OF THE WATER
RIGHT ONLY AND IS NOT INTENDED TO PROVIDE LEGAL
DIMENSIONS OR LOCATIONS OF PROPERTY OWNERSHIP LINES.

MAURICE E FARR, CWRE
395 NE KIRBY AVENUE
ROSEBURG, OR 97470

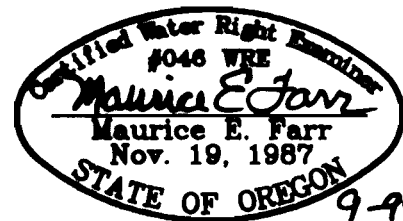

EXPIRES 12-31-99