

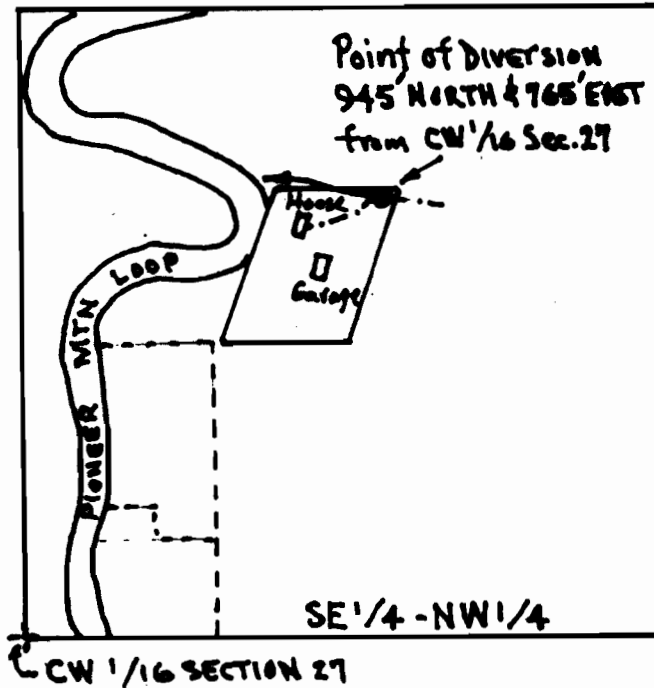


T10S, R10W., W.M.
SECTION 27
LINCOLN COUNTY, OREGON

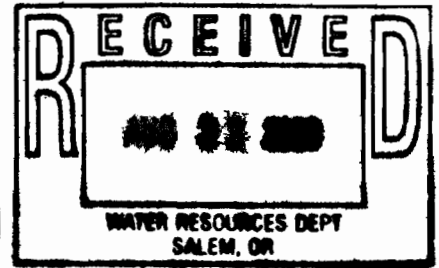

Scale: 1 inch = 400 feet

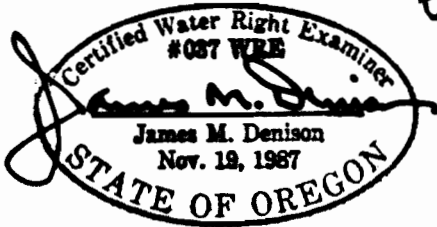

FINAL PROOF SURVEY
UNDER

APPLICATION # S-71986

PERMIT # 52061

IN THE NAME OF

ARNOLD W. AND BESSIE PEARSON

SURVEYED: July 14, 2000

BY: James M. Denison

THIS MAP PREPARED SOLEY FOR THE PURPOSE OF SHOWING LOCATION OF A WATER RIGHT, AND IS NOT INTENDED FOR USE TO PROVIDE DIMENSIONS OR LOCATION OF PROPERTY OWNERSHIP LINES.