


RECEIVED

SEP 20 1999

WATER RESOURCES DEPT.  
SALEM, OREGON

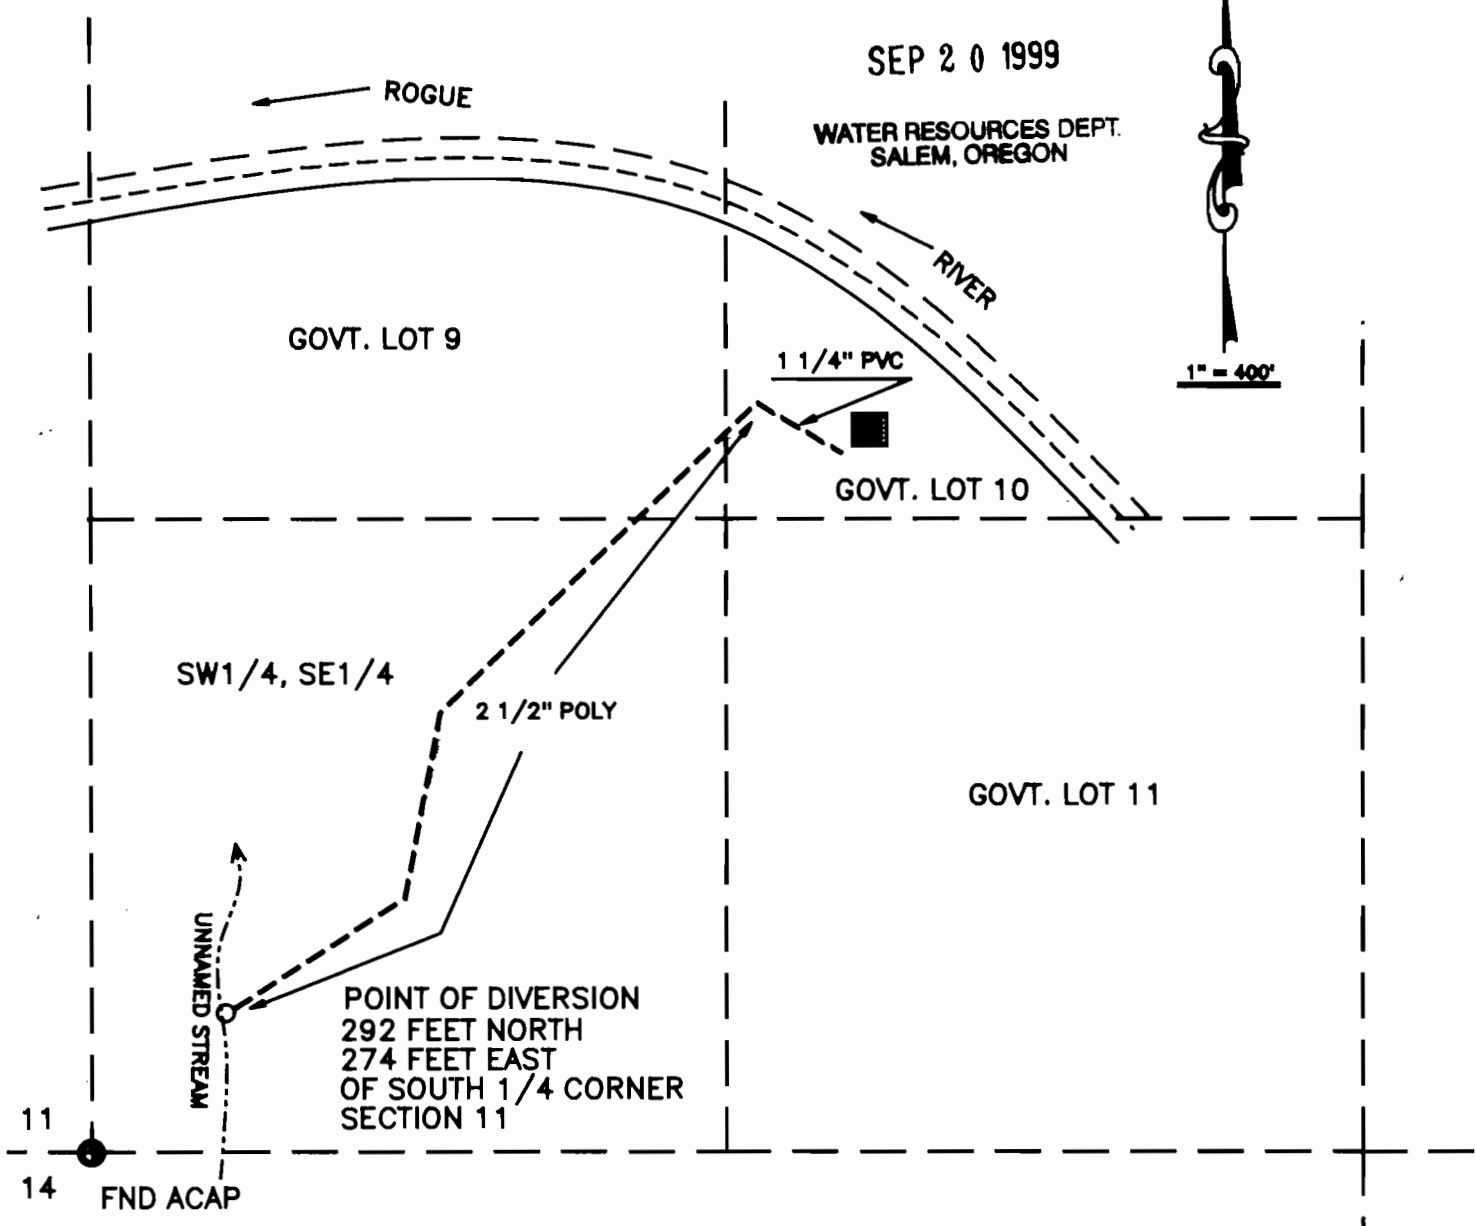

THE PREPARATION OF THIS MAP WAS FOR THE PURPOSE OF IDENTIFYING THE LOCATION OF THE PROPOSED WATER RIGHT AND HAS NO INTENT TO PROVIDE DIMENSIONS OR LOCATION OF PROPERTY LINES.

# FINAL PROOF SURVEY

APPLICATION #S-71512 PERMIT #51896



IN THE NAME OF  
PATRICK E. McCOOL  
SW 1/4, SE 1/4, SECTION 11  
T. 35 S., R. 12 W., W. M.

SURVEYED SEPTEMBER 8, 1999 BY BRYAN M. FLAVIN