


Section No. 72127  
Permit No. 51437

SECTION 30 T.2S. R.10W. W.M.  
TILLAMOOK COUNTY

1"=400'

ETARTS  
BAY

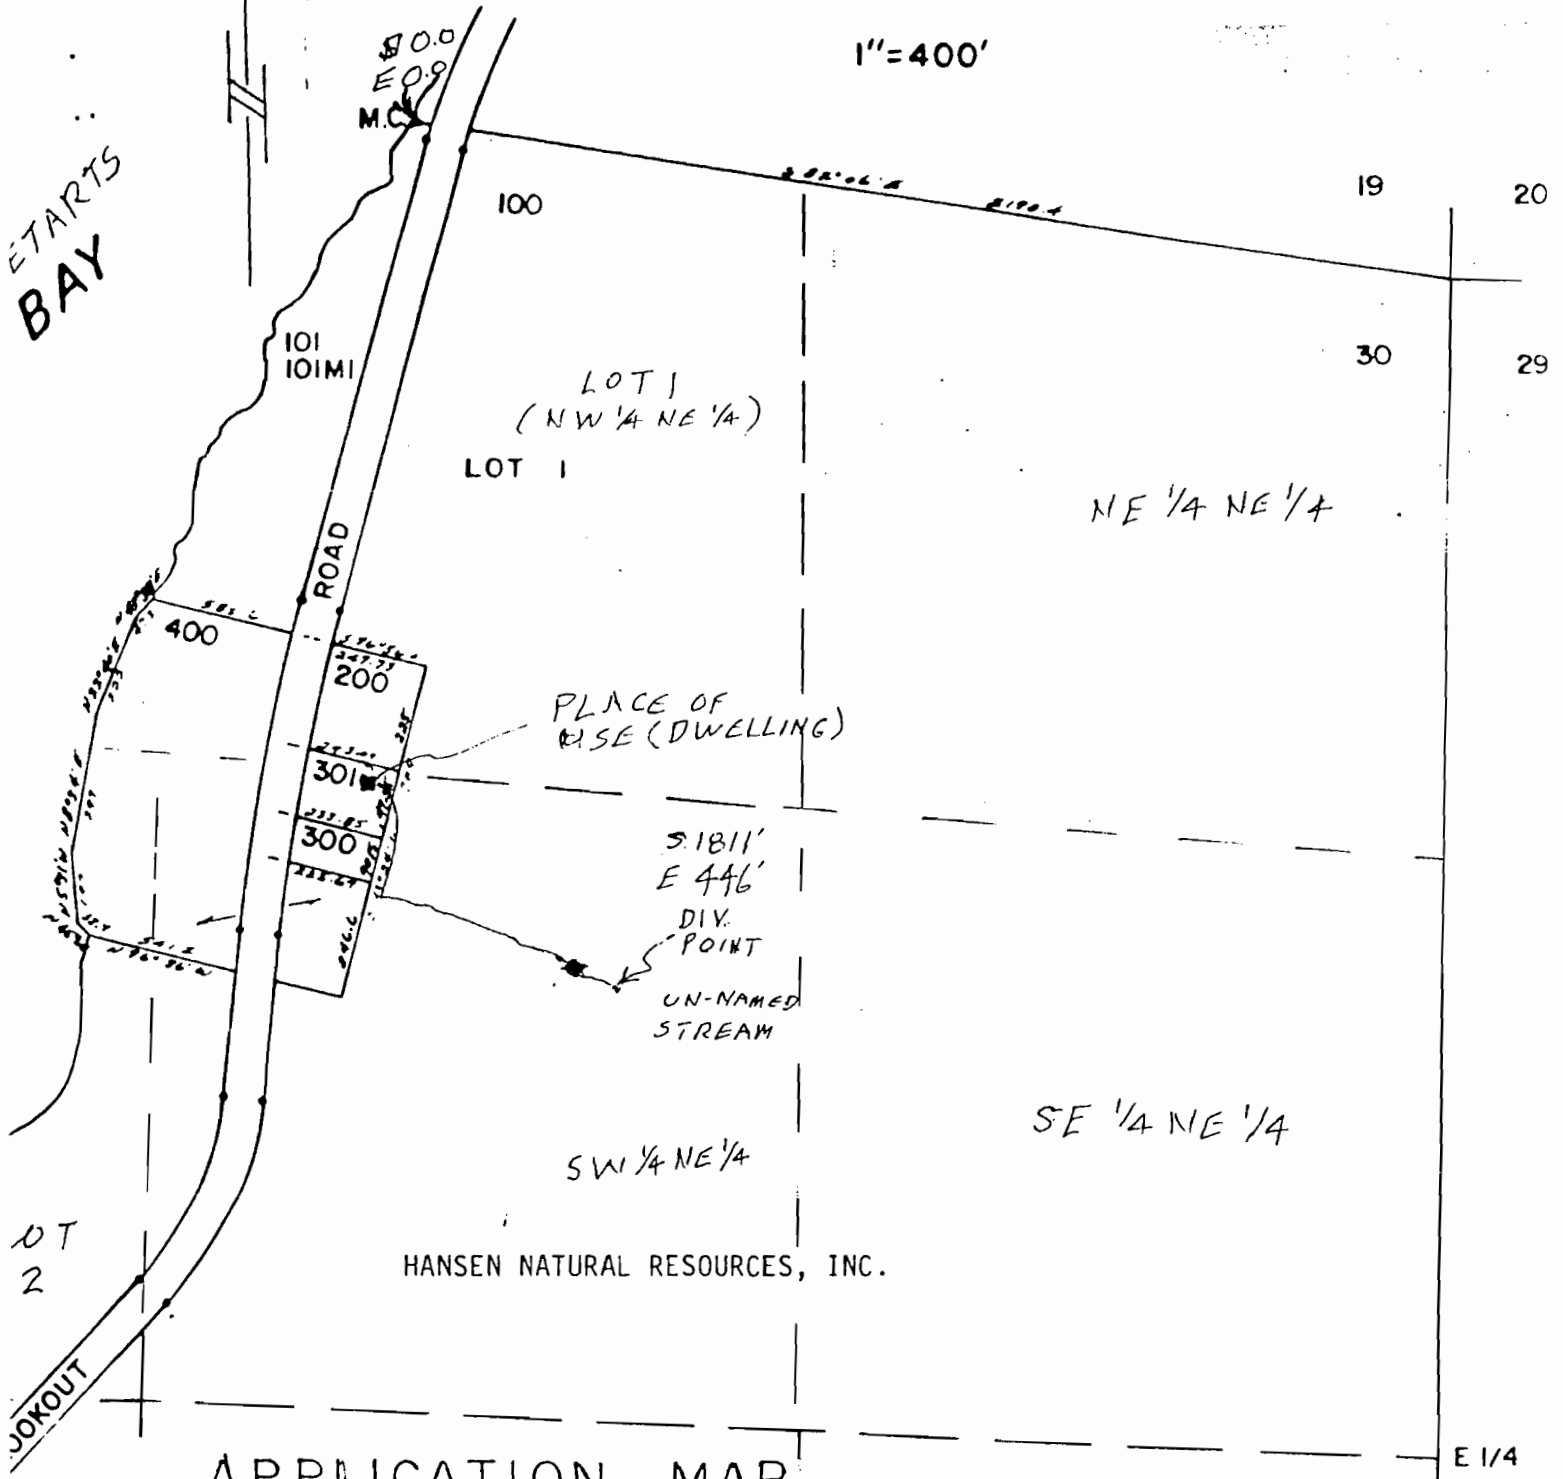

APPLICATION MAP

WILLIAM MURPHY/B.M. & WILMA HOERL

SW 1/4 NE 1/4 & Lot 1, Section


T. 2 S., R. 10 W., W.M.

Tillamook County, Oregon.

**RECEIVED**

DEC 26 2000

WATER RESOURCES DEPT.  
SALEM, OREGON

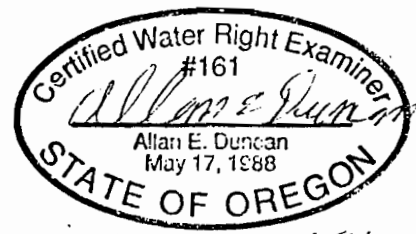

7 DEC. 1991