



Map of Proof Survey of Permit 53088 RRIP, LLC

T369, R1W, Sec 6
T368, R2W, Sec 1

RECEIVED

MAR 27 2008

WATER RESOURCES DEPT
SALEM, OREGON

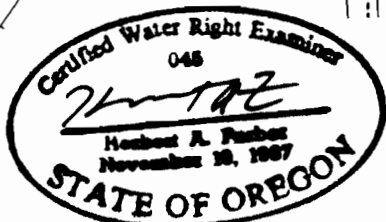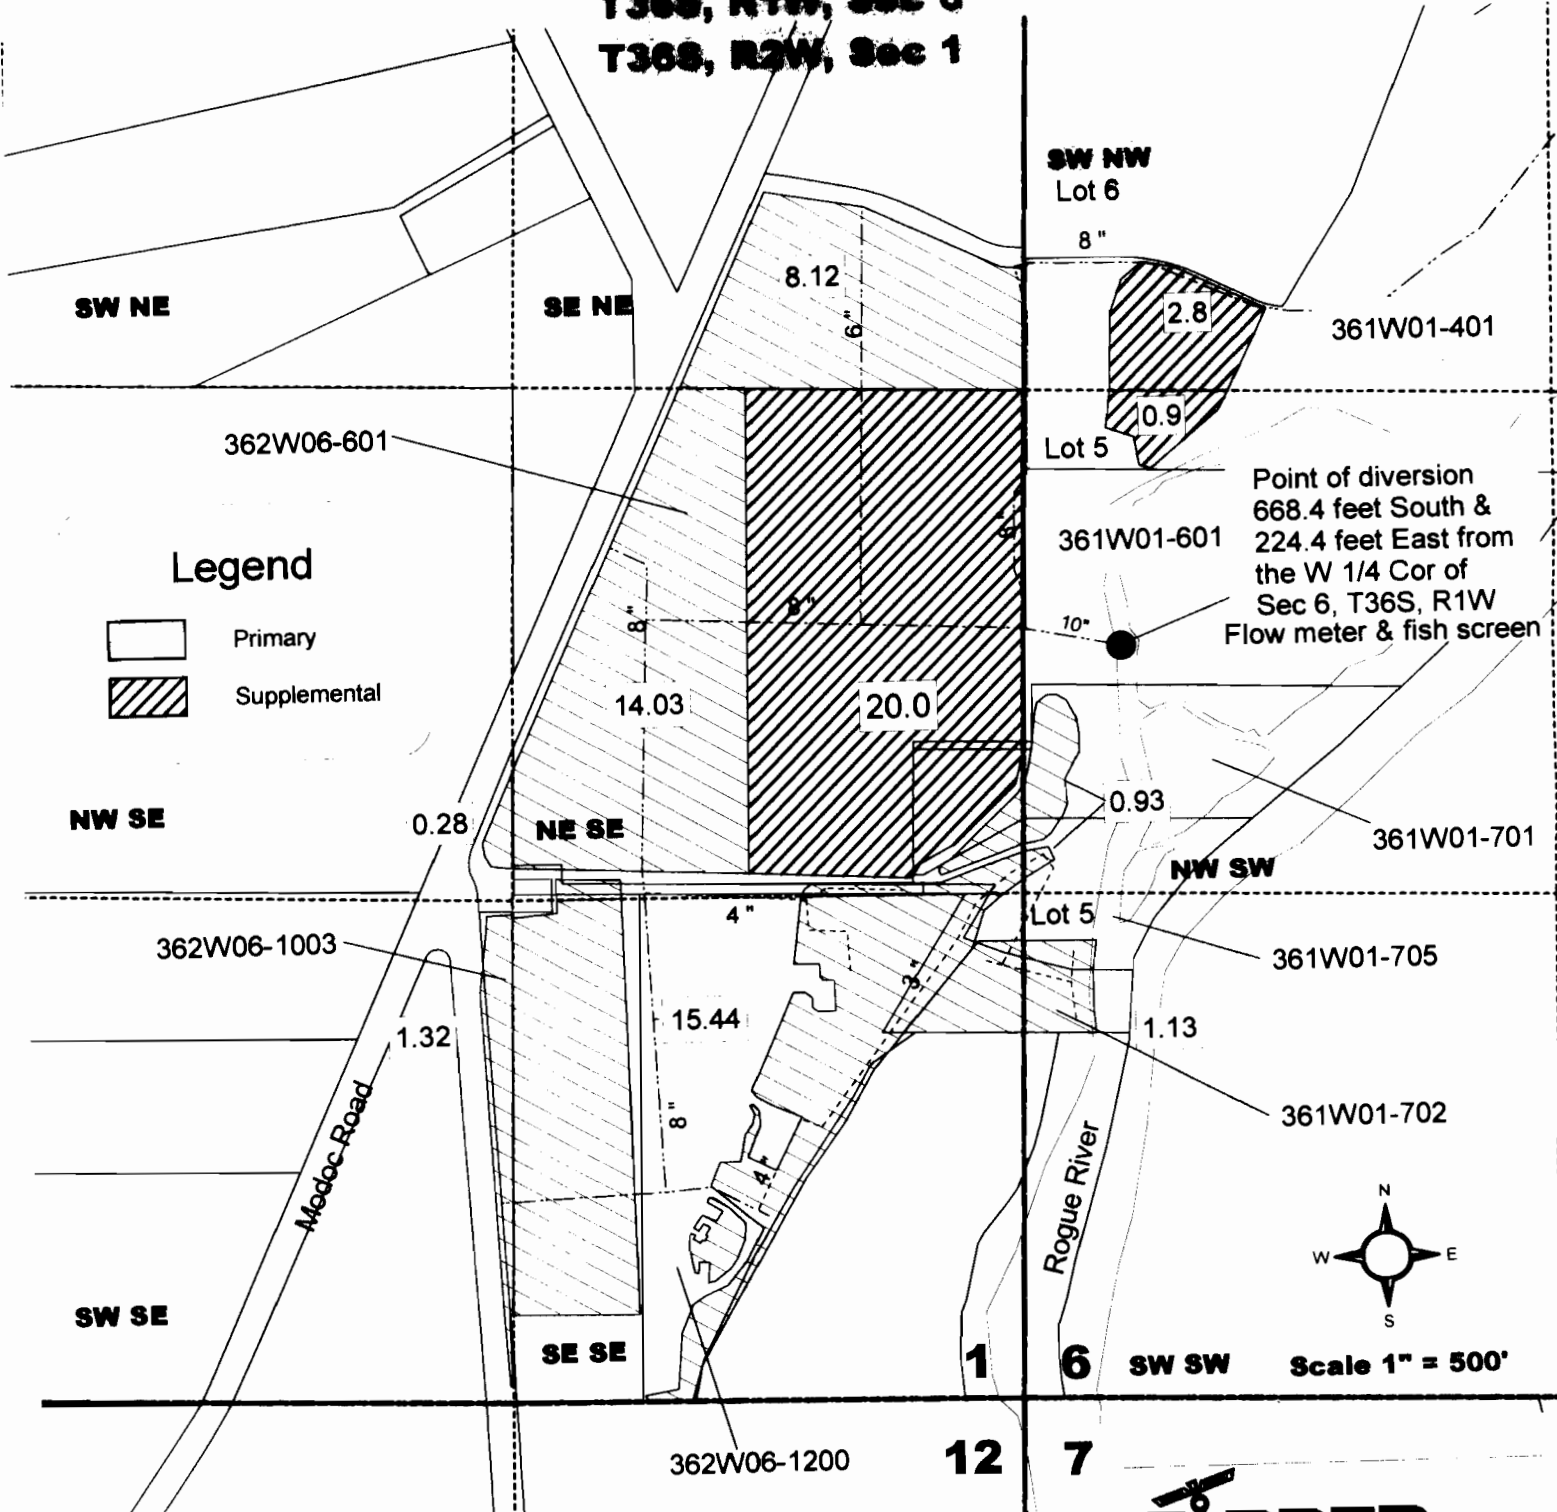

RENEWAL DATE 12-31-09

Note: This map for water right purposes only. It is not to be used for property line location.



PO Box 5286
Central Point, Oregon 97502
Phone 541-664-5599
Fax 541-664-5603
Email hfarber@charter.net

Farber & Sons, Inc.
431 Oak Street
Central Point, Oregon
Tax ID: 93-1057173