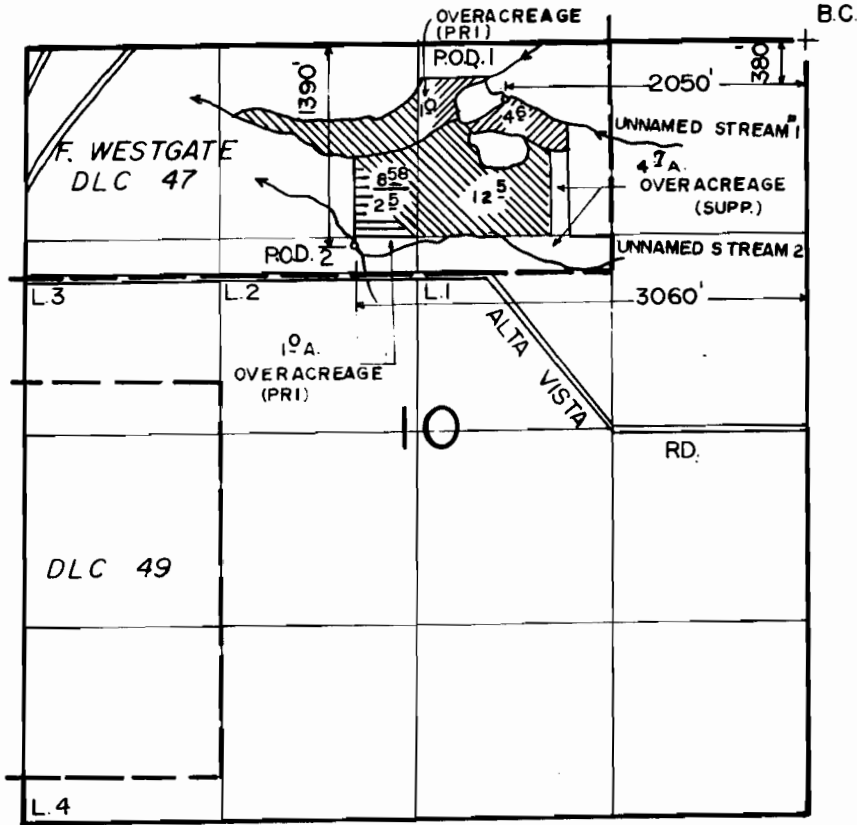
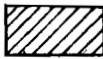

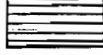
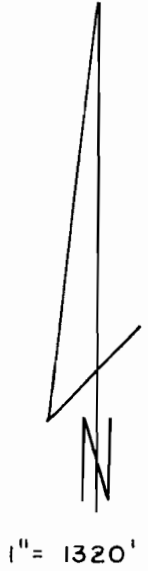


T. 36 S., R. 1 W., W.M.



-  PRIMARY
-  SUPPLEMENTAL CERT. # 20730 PRIOR. 3-19-47
-  SUPPLEMENTAL CERT. # 15781 PRIOR. 9-19-44



FINAL PROOF SURVEY UNDER

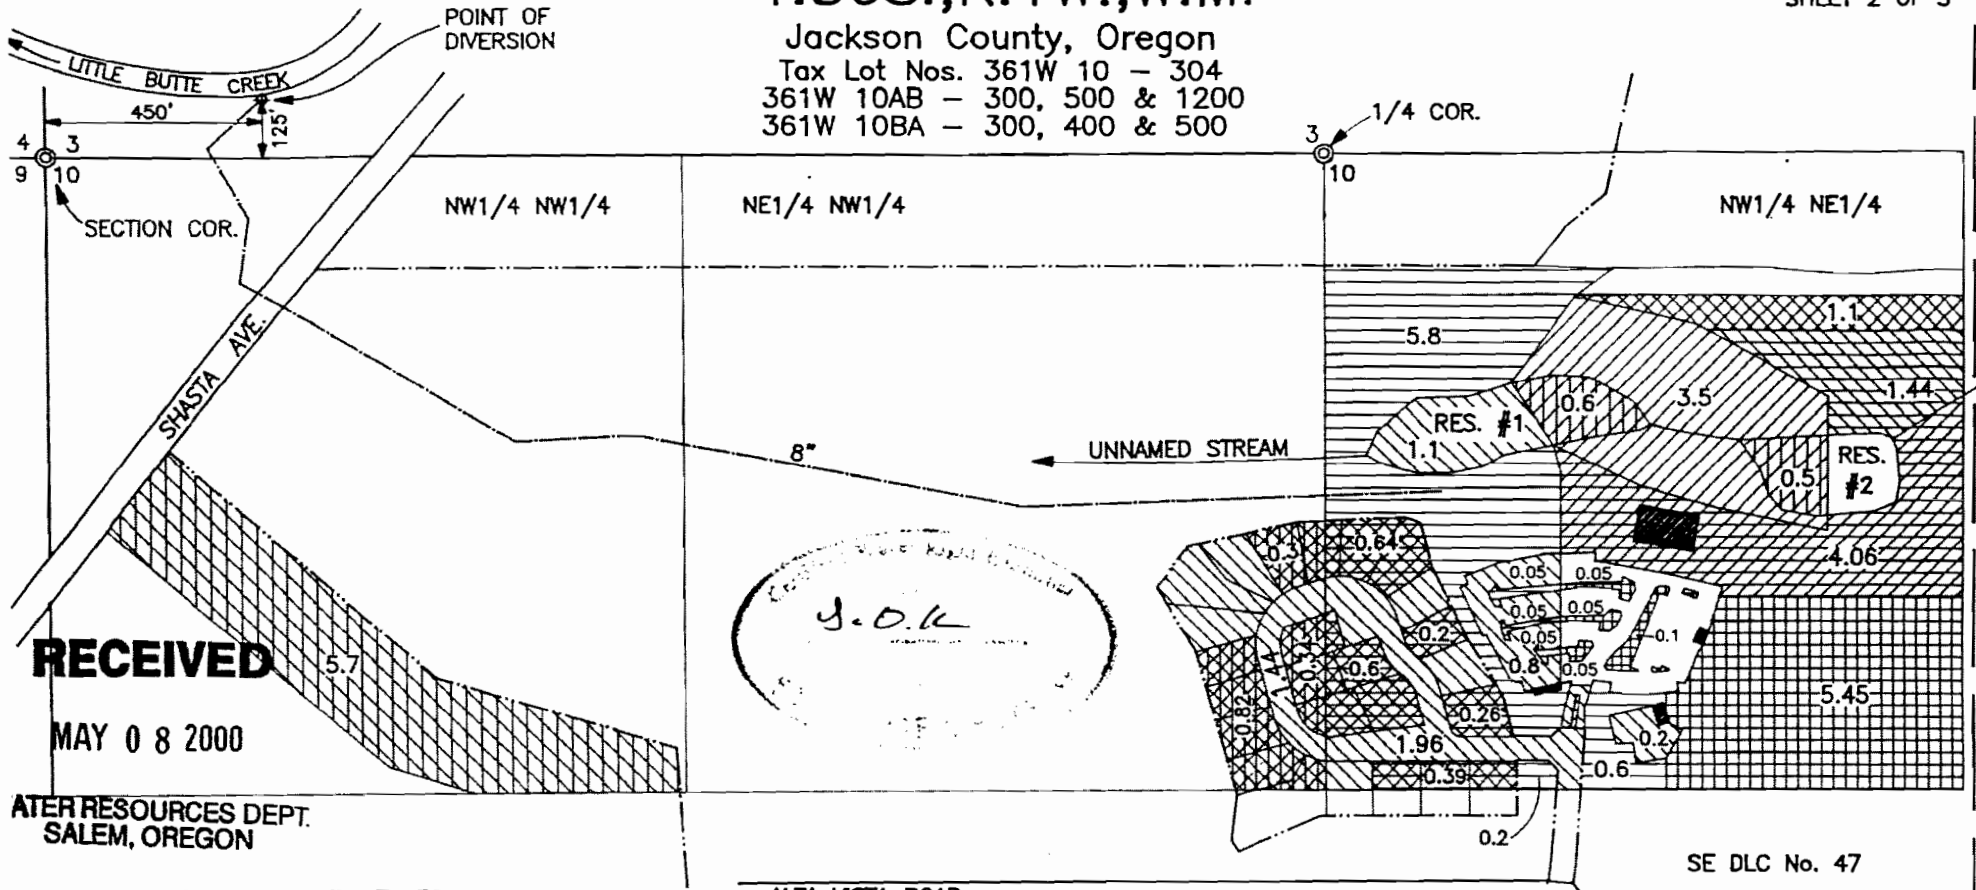
Application No. 66957 Permit No. 48316
IN NAME OF

STRAUS RANCHES

Surveyed OCT. 25 1989, by B.S. JAMES

I. JOSS., R. I.W., W.M.



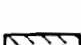

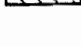
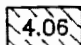
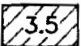
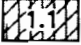
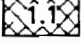
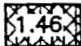


Jackson County, Oregon
Tax Lot Nos. 361W 10 - 304
361W 10AB - 300, 500 & 1200
361W 10BA - 300, 400 & 500



RECEIVED

MAY 08 2000

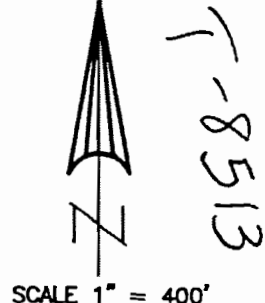
WATER RESOURCES DEPT.
SALEM, OREGON

-  PORTION OF PERMIT 15987 CERT. 75427 BEING TRANSFERRED TO NW1/4 NE1/4
-  PORTION OF NW1/4 NE1/4 RECEIVED PERMIT 15987, CERT. 75427 WATER
-  PORTION OF PERMIT 17621, CERT. 72476 IN NE1/4 NW1/4 BEING TRANSFERRED TO NW1/4 NE1/4
-  PORTION OF NW1/4 NE1/4 RECEIVING WATER FROM PERMIT 17621, CERT. 72476 FROM NE1/4 NW1/4
-  PORTION OF PERMIT 17621, CERT. 72476 IN NW1/4 NE1/4 BEING TRANSFERRED WITHIN NW1/4 NE1/4
-  PORTION OF NW1/4 NE1/4 RECEIVING WATER FROM PERMIT 17621, CERT. 72476 FROM NW1/4 NE1/4
-  PORTION OF CERT. 66056 NO CHANGE
-  PORTION OF CERT. 66056 BEING TRANSFERRED WITHIN NW1/4 NE1/4
-  PORTION OF NW1/4 NE1/4 RECEIVING WATER FROM CERT. 66056
-  PORTION OF PERMIT 17621, CERT. 72476 IN NE1/4 NW1/4 NO CHANGE, OUTSIDE EPGC PROPERTY
-  PORTION OF PERMIT 17621, CERT. 72476 IN NW1/4 NE1/4 NO CHANGE, WITHIN EPGC PROPERTY
-  PORTION OF PERMIT 17621, CERT. 72476 IN NW1/4 NE1/4 NO CHANGE, OUTSIDE EPGC PROPERTY

NOTE: MAP PREPARED FOR WATER RIGHT PURPOSES ONLY, NOT FOR PROPERTY BOUNDARY LOCATIONS.

MAP TO ACCOMPANY A TRANSFER APPLICATION (Change in Place of Use)

FOR: Eagle Point Golf Course
100 Eagle Point Drive
Eagle Point, OR. 97524



PREPARED BY:
Gary D. Kaiser
Kaiser Surveying
19440 Hwy. 62
Eagle Point, OR. 97524
March 20, 2000

7-8513