

~~MAP 3~~

P. 17621
Pt. Mar 19,
1947

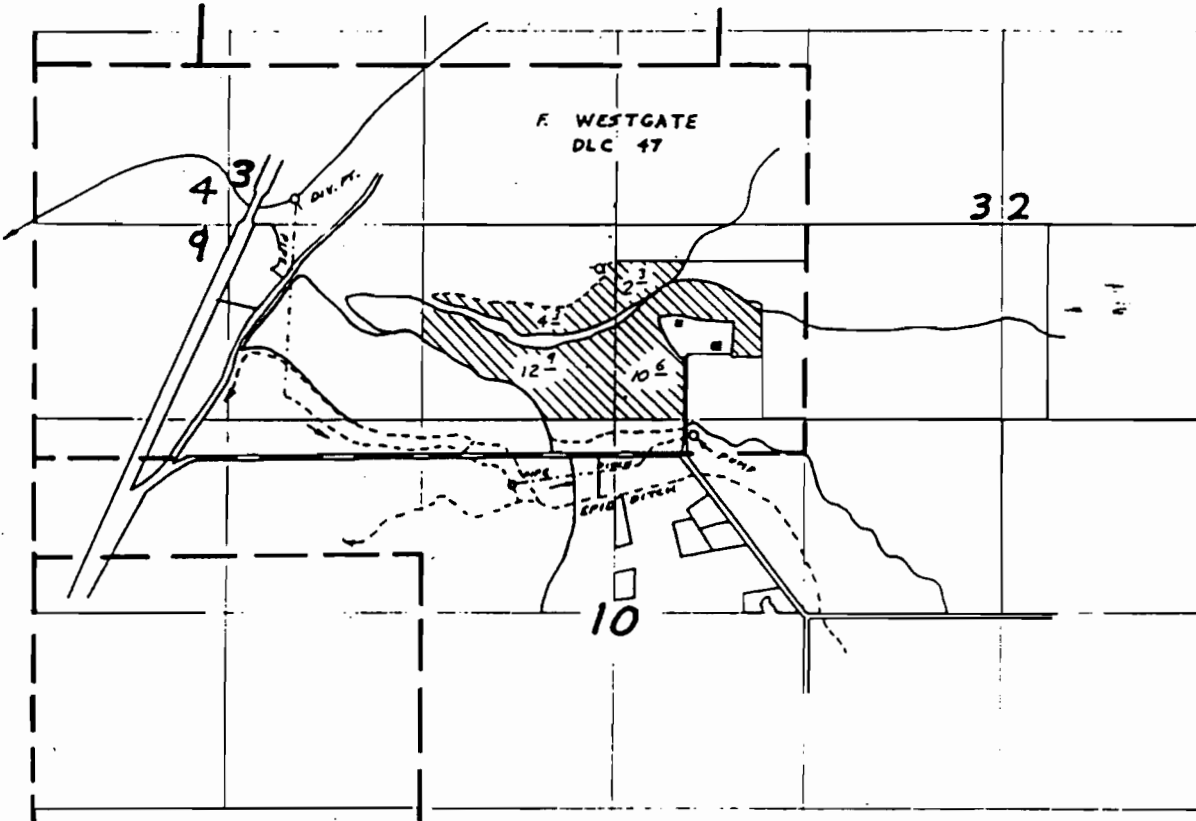
MAP 2

RECEIVED

T. 36 S., R. 1 W., W. M.

APR 15 1996

WATER RESOURCES DEPT.
SALEM, OREGON



FINAL PROOF SURVEY
UNDER

CERT. No. 20730

Application No. 22350 Permit No. 17621

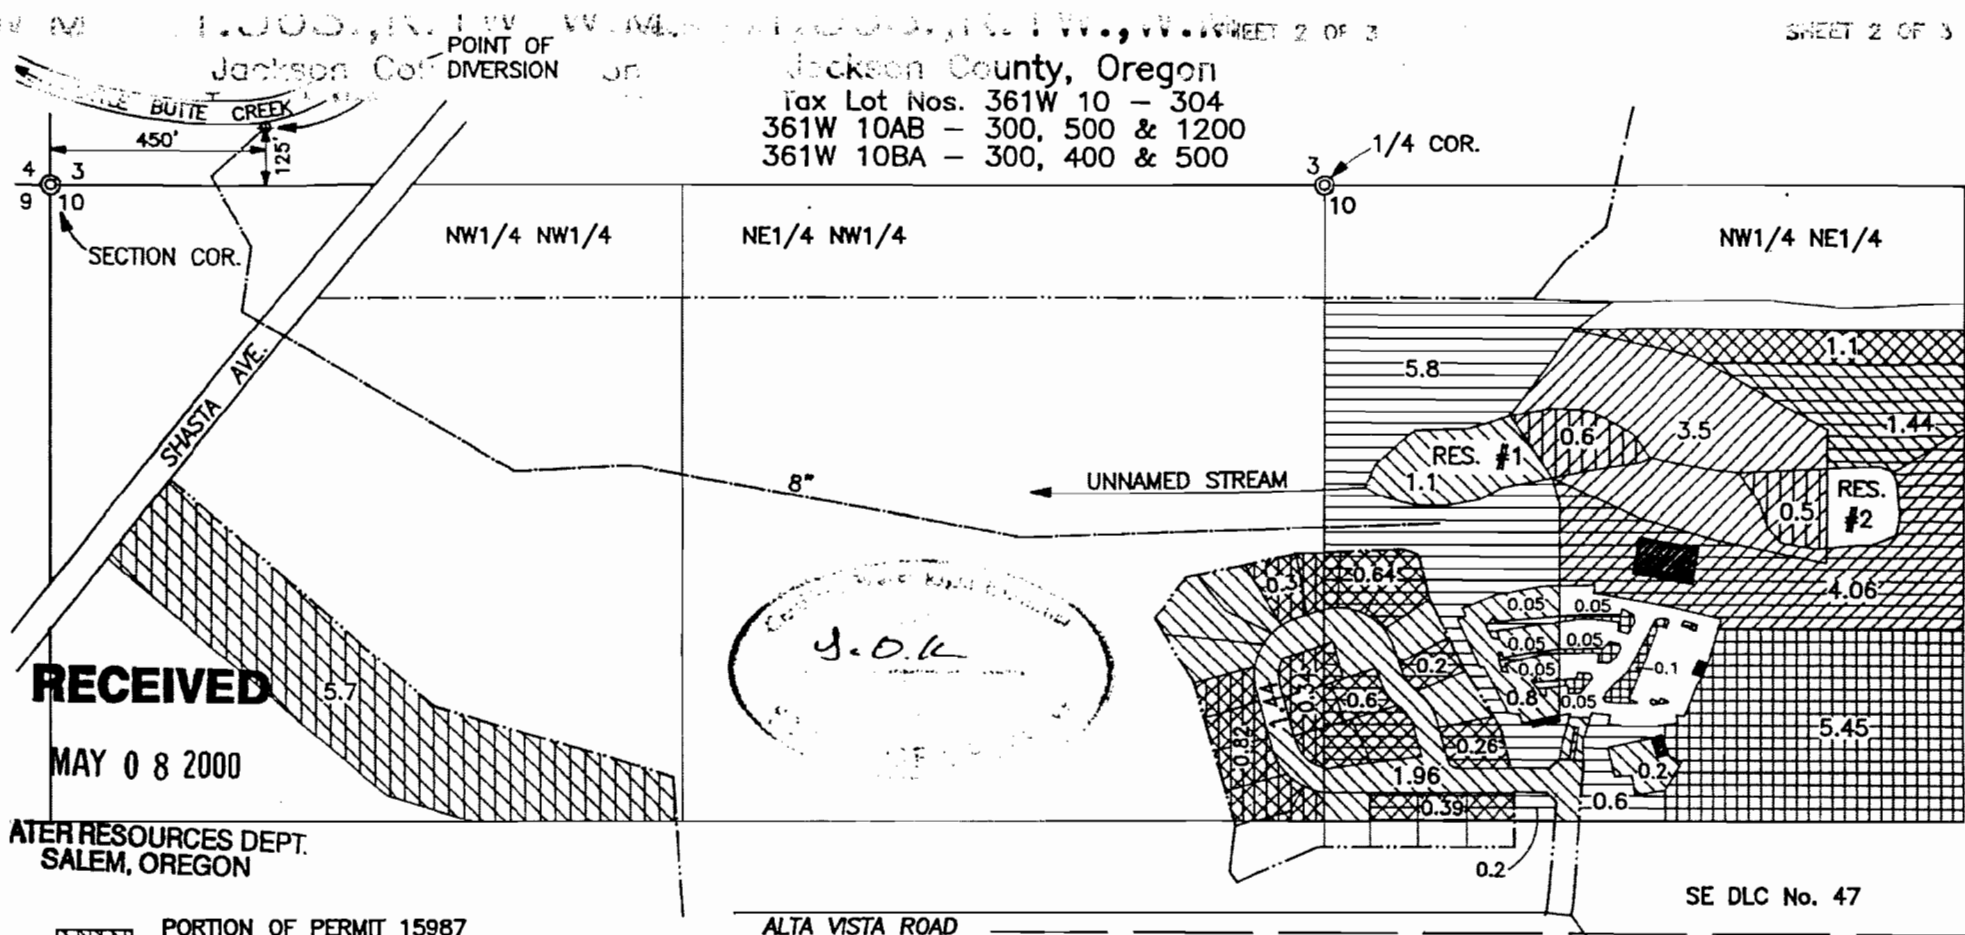
IN NAME OF

ALA VISTA ORCHARDS

Surveyed DEC 12 1980, by B.P. SUND

scale: 4" = 1 mile

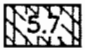
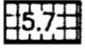
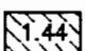
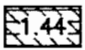
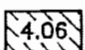
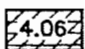
BAX-3AA-6
EPID PHOTO 66

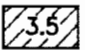
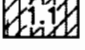

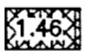
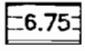
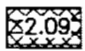


RECEIVED

MAY 08 2000

WATER RESOURCES DEPT.
 SALEM, OREGON

-  PORTION OF PERMIT 15987 CERT. 75427 BEING TRANSFERRED TO NW1/4 NE1/4
-  PORTION OF NW1/4 NE1/4 RECEIVED PERMIT 15987, CERT. 75427 WATER
-  PORTION OF PERMIT 17621, CERT. 72476 IN NE1/4 NW1/4 BEING TRANSFERRED TO NW1/4 NE1/4
-  PORTION OF NW1/4 NE1/4 RECEIVING WATER FROM PERMIT 17621, CERT. 72476 FROM NE1/4 NW1/4
-  PORTION OF PERMIT 17621, CERT. 72476 IN NW1/4 NE1/4 BEING TRANSFERRED WITHIN NW1/4 NE1/4
-  PORTION OF NW1/4 NE1/4 RECEIVING WATER FROM PERMIT 17621, CERT. 72476 FROM NW1/4 NE1/4

-  PORTION OF CERT. 66056 NO CHANGE
-  PORTION OF CERT. 66056 BEING TRANSFERRED WITHIN NW1/4 NE1/4
-  PORTION OF NW1/4 NE1/4 RECEIVING WATER FROM CERT. 66056
-  PORTION OF PERMIT 17621, CERT. 72476 IN NE1/4 NW1/4 NO CHANGE, OUTSIDE EPGC PROPERTY
-  PORTION OF PERMIT 17621, CERT. 72476 IN NW1/4 NE1/4 NO CHANGE, WITHIN EPGC PROPERTY
-  PORTION OF PERMIT 17621, CERT. 72476 IN NW1/4 NE1/4 NO CHANGE, OUTSIDE EPGC PROPERTY

NOTE: MAP PREPARED FOR WATER RIGHT PURPOSES ONLY, NOT FOR PROPERTY BOUNDARY LOCATIONS.

MAP TO ACCOMPANY A TRANSFER APPLICATION (Change in Place of Use)

FOR: Eagle Point Golf Course
 100 Eagle Point Drive
 Eagle Point, OR. 97524



SCALE 1" = 400'

PREPARED BY:
 Gary D. Kaiser
 Kaiser Surveying
 19440 Hwy. 62
 Eagle Point, OR.
 97524

March 20, 2000

T-8513

J.O.K.