

RECEIVED

CLAIM OF BENEFICIAL USE FINAL PROOF MAP

APR 25 2000

Located in the NW¼ NE¼ & NE¼ NE¼ of Section 14,
Township 41 South, Range 12 West, W.M.


Curry County, Oregon

Application # S-72532 Permit #52239

WATER RESOURCES DEPT.
SALEM, OREGON

POB

POB N¼ SEC. 14

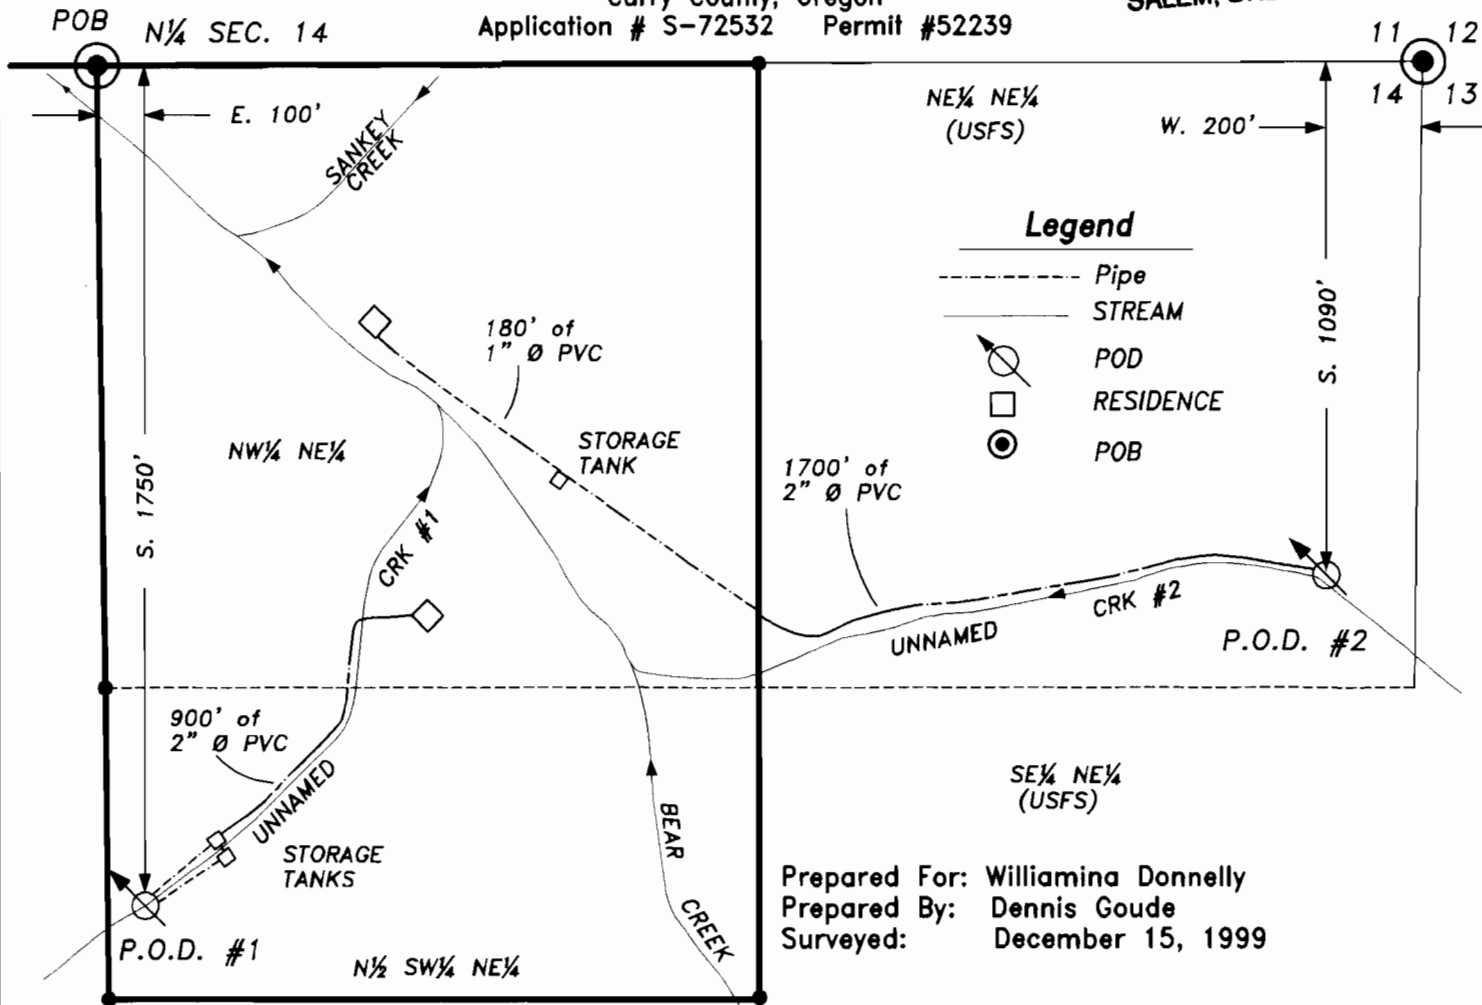

Prepared For: Williamina Donnelly
Prepared By: Dennis Goude
Surveyed: December 15, 1999

NOTE:

P.O.D. #1 IS AN INSTREAM 2' X 3' WOODEN BOX WITH A SCREENED OUTLET PIPE. 900 FEET OF 2" DIAMETER PVC PIPE CONNECT TO THE STORAGE TANKS AND THE PLACE OF USE. THE P.O.D. IS LOCATED 1750 FEET SOUTH AND 100 FEET EAST FROM THE NORTH ¼ CORNER OF SECTION 14.

P.O.D. #2 IS AN INSTREAM 2' X 3' PLASTIC BOX WITH A SCREENED OUTLET PIPE. 1700' OF 2" DIAMETER PIPE CONNECT TO THE STORAGE TANKS AND 180' OF 1" DIAMETER PIPE CONNECT TO THE PLACE OF USE FROM STORAGE. THE P.O.D. IS LOCATED 1090 FEET SOUTH AND 200 FEET WEST FROM THE NORTH-EAST CORNER OF SECTION 14.

EXAMINERS DISCLAIMER STATEMENT

The preparation of this map was for the purpose of identifying the location of the Water Right only and has no intent to provide dimensions or location of property ownership lines.

Scale 1" = 400 Feet



EXPIRES 06/30/2001

**Stuntzner Engineering
& Forestry**

705 So. 4th Street
P.O. Box 118
Coos Bay, Oregon 97420

Phone (541) 267-2872
Fax (541) 267-0588