


NW 1/4, SW 1/4, SEC. 25, T. 13 S., R. 4 E., W. M.

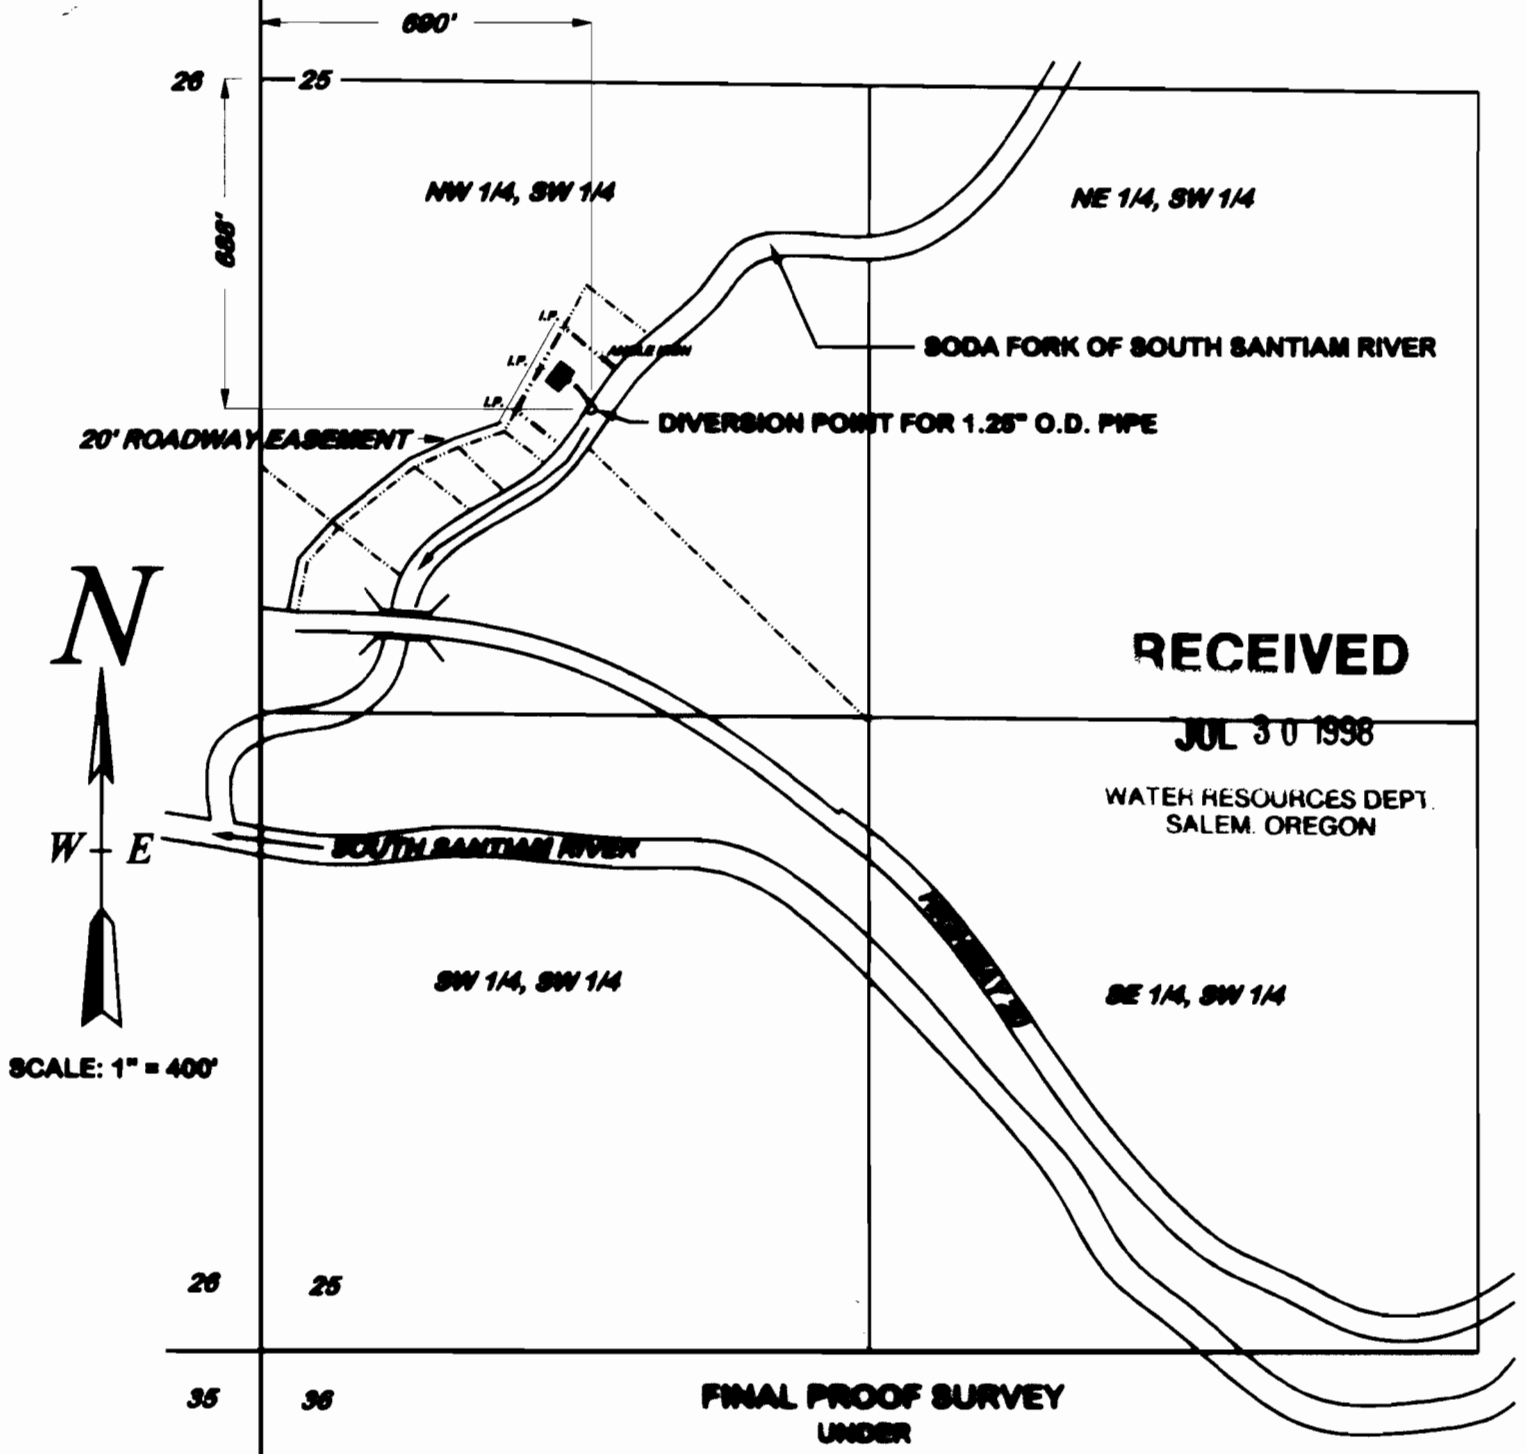

**FINAL PROOF SURVEY
UNDER**

APPLICATION No. S-72435
PERMIT No. S1988

IN NAME OF

ALYCE C. WITTE

SURVEYED SEPTEMBER 25, 1997, BY R. Jones

CAD: R. JONES

NOTE:

THE PURPOSE OF THIS MAP IS FOR THE LOCATION
OF A WATER RIGHT AND IS NOT INTENDED TO PROVIDE
LEGAL DEMENSIONS FOR LOCATIONS OF PROPERTY
BOUNDARIES.

BUSINESS OFFICE AT:
CASCADE TIMBER CONSULTING, INC.
3210 HWY. 20, P.O. BOX 446
SWEET HOME, OREGON 97386
PHONE: (541) 367-2111