


RECEIVED

FINAL PROOF SURVEY
for CHARLES SUTTON in the
SE 1/4, NE 1/4, SECTION 24
T 40 S, R 14 W, W.M.
Curry County, Oregon

JAN - 9 1996
WATER RESOURCES DEPT.
SALEM, OREGON

Application No. 72404
Permit No. 51654

scale: 1" = 400' December, 1995

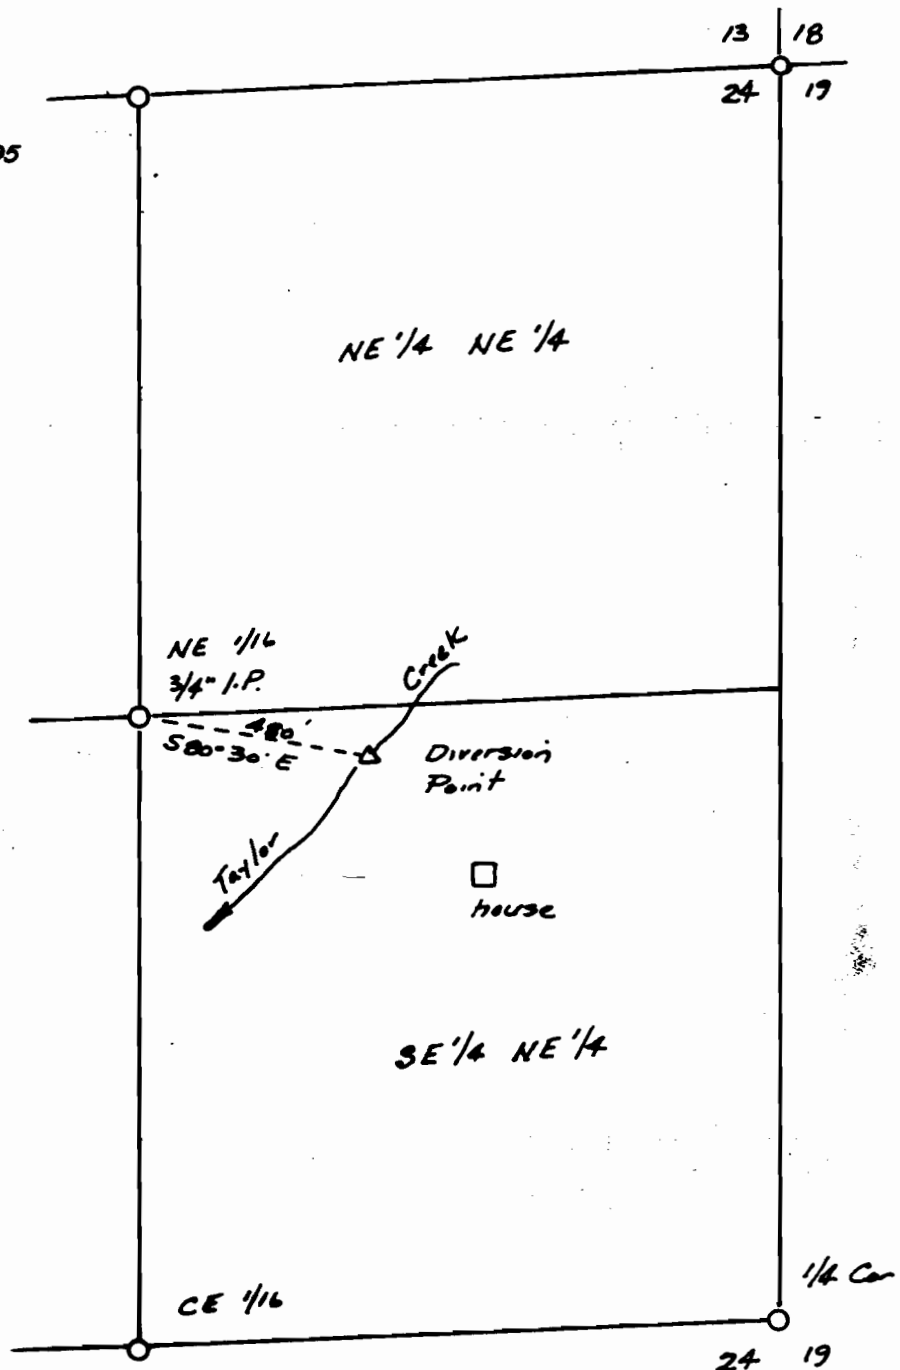

This map is for the purpose of
identifying the location of a water right
only and is not intended to provide legal
dimensions or locations of property
ownership lines.

72404



Donald Cormack, CWRE No. 29
P.O. Box 1280
Brookings, Oregon, 97415