


RECEIVED

MAY - 8 1998

WATER RESOURCES DEPT.
SALEM, OREGON

T 25 S, R 24 E, WM

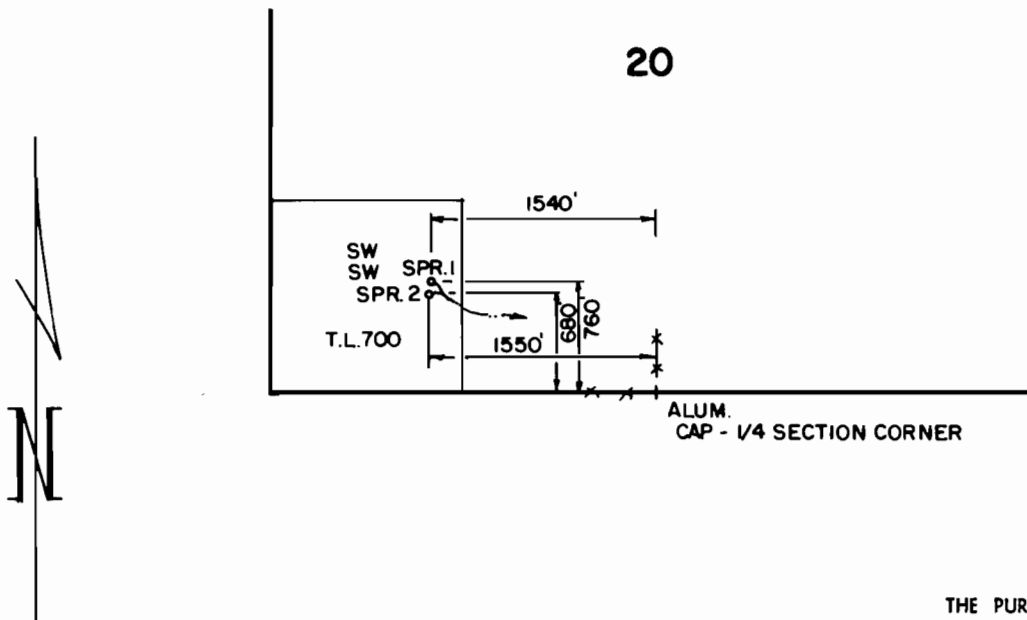

THE PURPOSE OF THIS MAP IS TO
IDENTIFY THE LOCATION OF THE
WATER RIGHT. IT IS NOT INTENDED
TO PROVIDE INFORMATION RELATIVE
TO THE LOCATION OF PROPERTY
OWNERSHIP.

FINAL PROOF SURVEY

UNDER
APPLICATION NO. S-72380
PERMIT NO. 52832

IN THE NAME OF
MIKE & PETE
WILLIAMS

Scale: 4" = 1 MILE

Date: APRIL 1998

Job: 1380

Drawn:

Drawn: CHRIS

Checked:

MAP'S

M. A. PALMER & SONS, INC.
ENGINEERING & SURVEYING
254 N. Alder - Box 61
Bums, Oregon 97720

Sht. No.

of 1

