


T.36 S. R.07 W. SEC. 2 W.M. RECEIVED

PREPARED BY:
JONATHAN C. SPERO C.W.R.E. 123
1002 KINCAID RD./P.O. BOX 16
WILLIAMS, OREGON 97544
PH. (541) 846-6845

SEP 21 1999


WATER RESOURCES DEPT
SALEM, OREGON

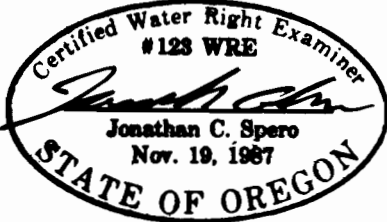

LICENSE RENEWAL DATE:
JUNE 30, 2000

● FOUND 5/8" IRON ROD PER
FERRY PARK EST. SUB.

SCALE: 1" = 400'

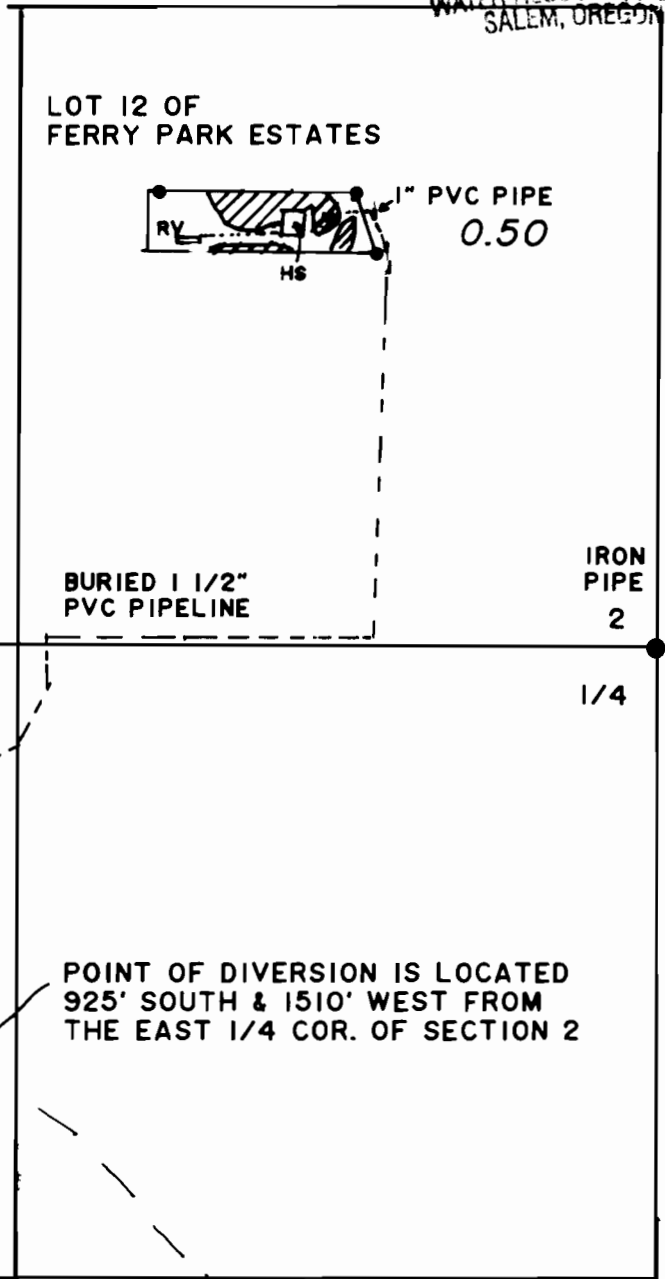

FINAL PROOF SURVEY

UNDER

APPLICATION No. S-72977

PERMIT No. 51702

IN NAME OF

ARTHUR G. GUEVARA

SURVEYED SEPTEMBER 9, 1999 BY: JONATHAN C. SPERO