

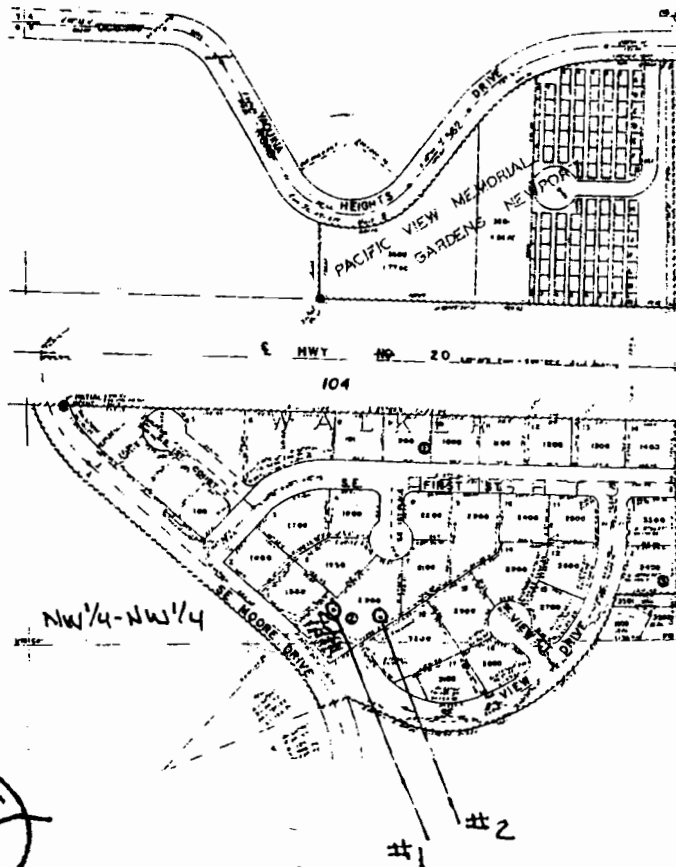


T11S, R11W., W.M.
SECTION 9
LINCOLN COUNTY, OREGON

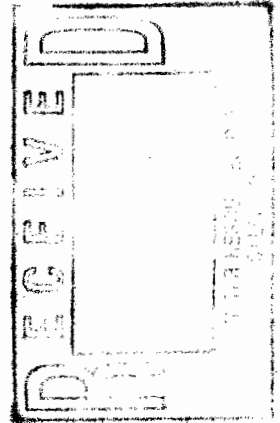

NW 1/16 SEC 9

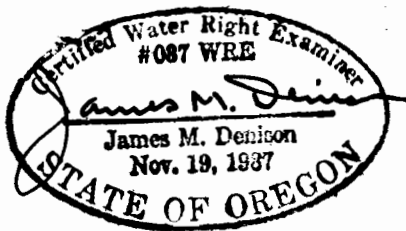

POD:
#1: 65' N & 720' W

#2: 50' N & 600' W, BOTH FROM NW 1/16 COR, Sec 9

FINAL PROOF SURVEY
UNDER

Scale: 1 inch = 400 feet

APPLICATION # S-72933

PERMIT # 52547

IN THE NAME OF

David and Jill Capri

SURVEYED: March 10, 2001

BY: James M. Denison

THIS MAP PREPARED SOLEY FOR THE PURPOSE OF SHOWING LOCATION OF A WATER RIGHT, AND IS NOT INTENDED FOR USE TO PROVIDE DIMENSIONS OR LOCATION OF PROPERTY OWNERSHIP LINES.

Final Proof Map

Amended by WRD Staff, 6-19-08 jwg