


CLAIM OF BENEFICIAL USE
 FOR: SCOTT A. & BEVERLY LANGKAMP
 BY DUANE W. KIRBY
 T24S, R6W, S19 W.M.
 APPLICATION NO S72877
 PERMIT NO S52152
 TAX LOT 300

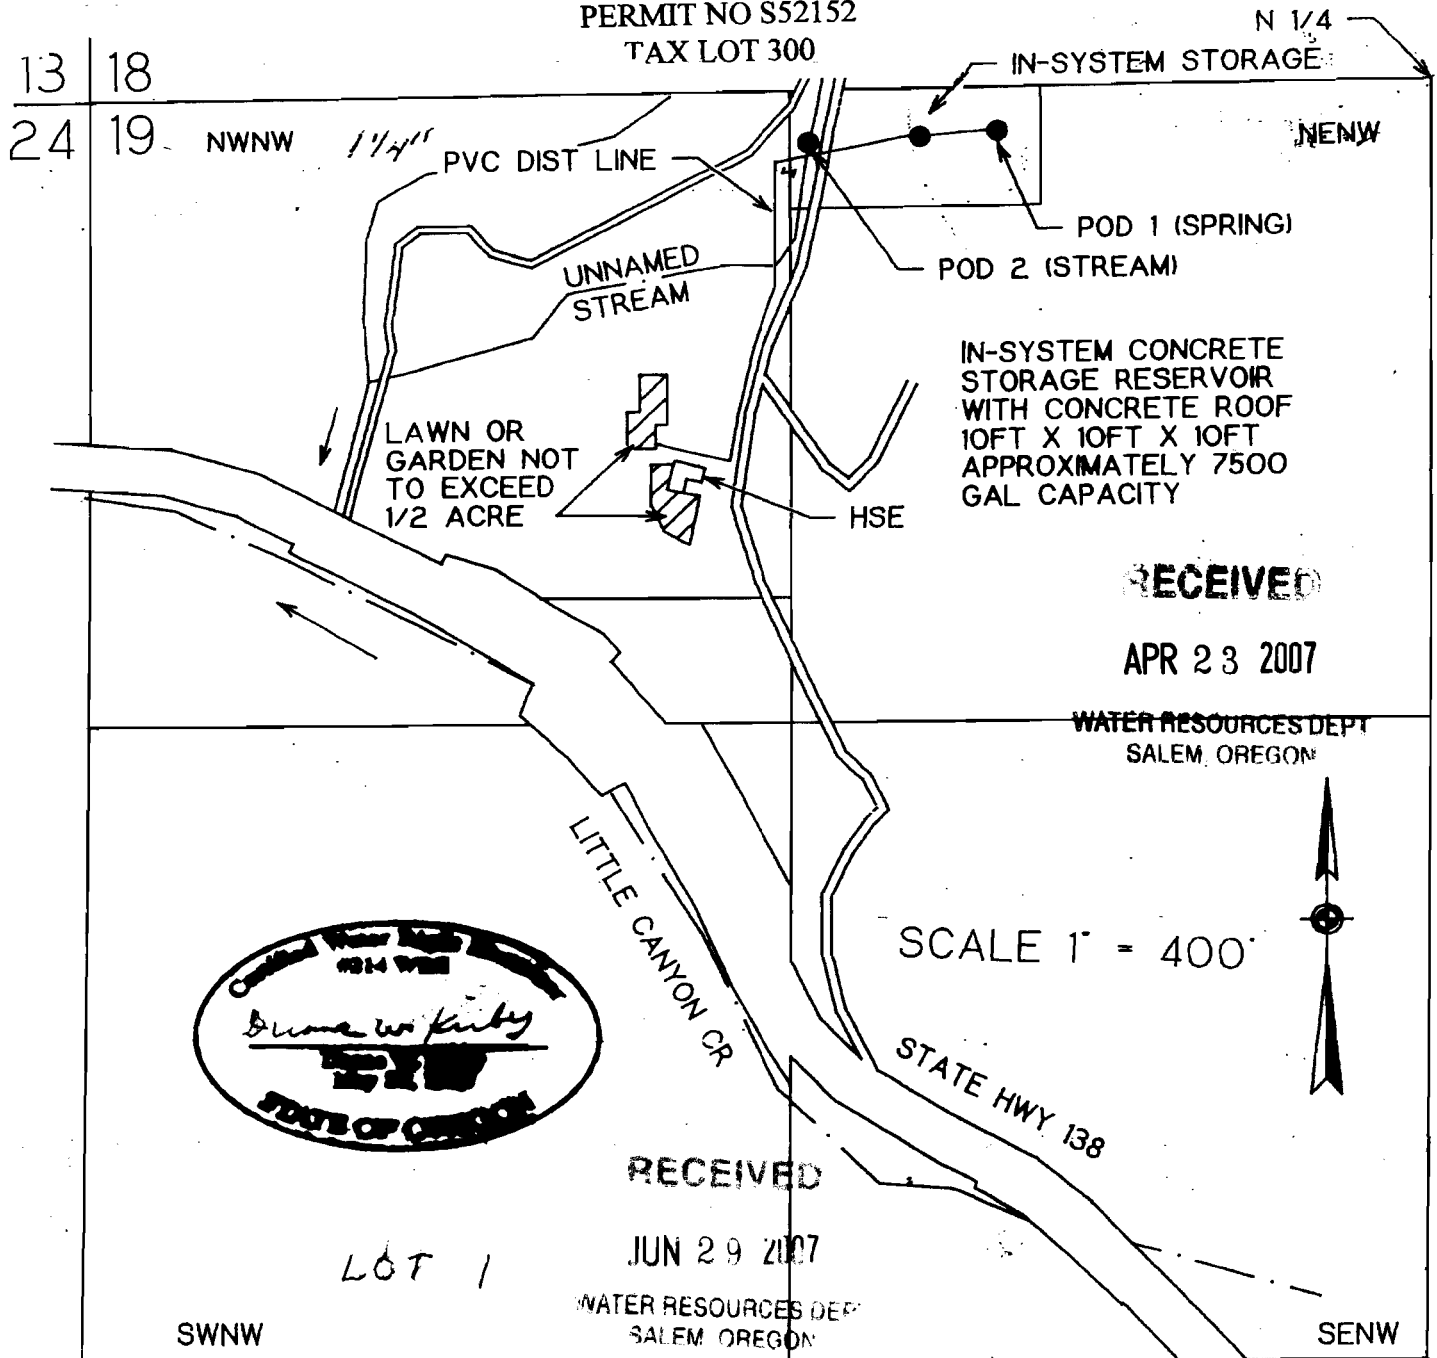

POD 1 (SPRING) IS 90 FT S AND 900 FT W FROM N 1/4 COR SEC 19
 POD 2 (STREAM) IS 110 FT S AND 1290 FT W FROM N 1/4 COR SEC 19

THIS IS A LOCATION MAP FOR A WATER RIGHT APPLICATION BY SCOTT A OR BEVERLY ANN LANGKAMP. THIS MAP IS FOR THE PURPOSE OF IDENTIFYING THE LOCATION OF THE WATER RIGHT ONLY AND IS NOT INTENDED TO PROVIDE LEGAL DIMENSIONS OR LOCATIONS OF PROPERTY OWNERSHIP LINES.