


SEC. 26, T29S R13WWM

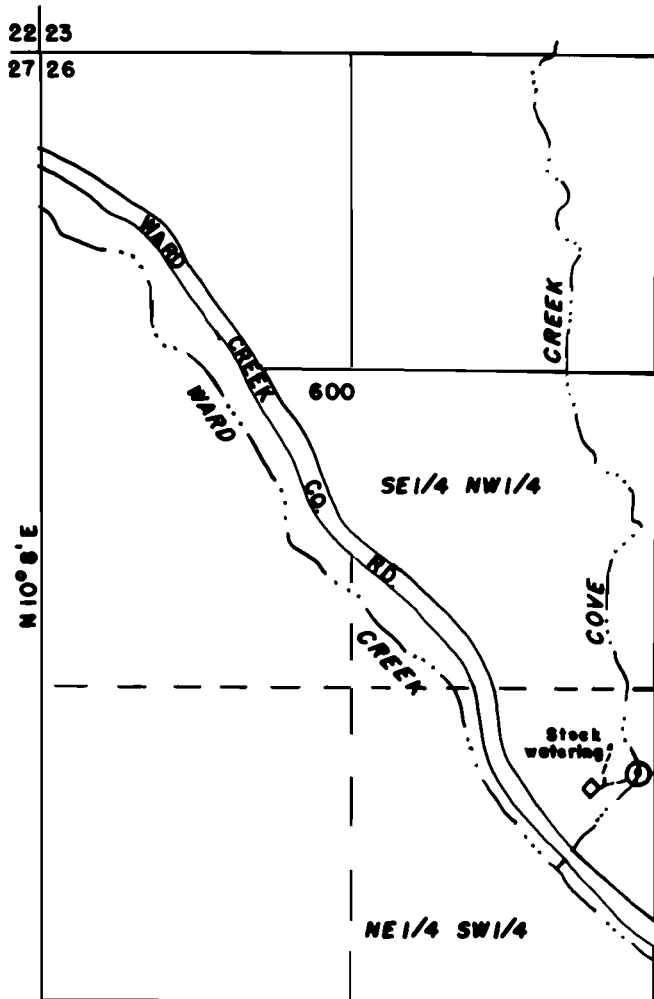

Scale: 1" = 800'

The point of diversion is located S 39° 23' E a distance of 3850' from the section between sections 22, 23, 26 & 27.



FINAL PROOF SURVEY UNDER

RECEIVED

SEP 26 2000

WATER RESOURCES DEPT.
SALEM, OREGON

Application No. ... 73080 Permit No. 52702.

MARVIN HAMMACK

Surveyed 9-2-2000 by K. Phelps