


RECEIVED

MAY 17 1999

WATER RESOURCES DEPT.
SALEM, OREGON

T13S, R6W, W.M.
SECTION 13

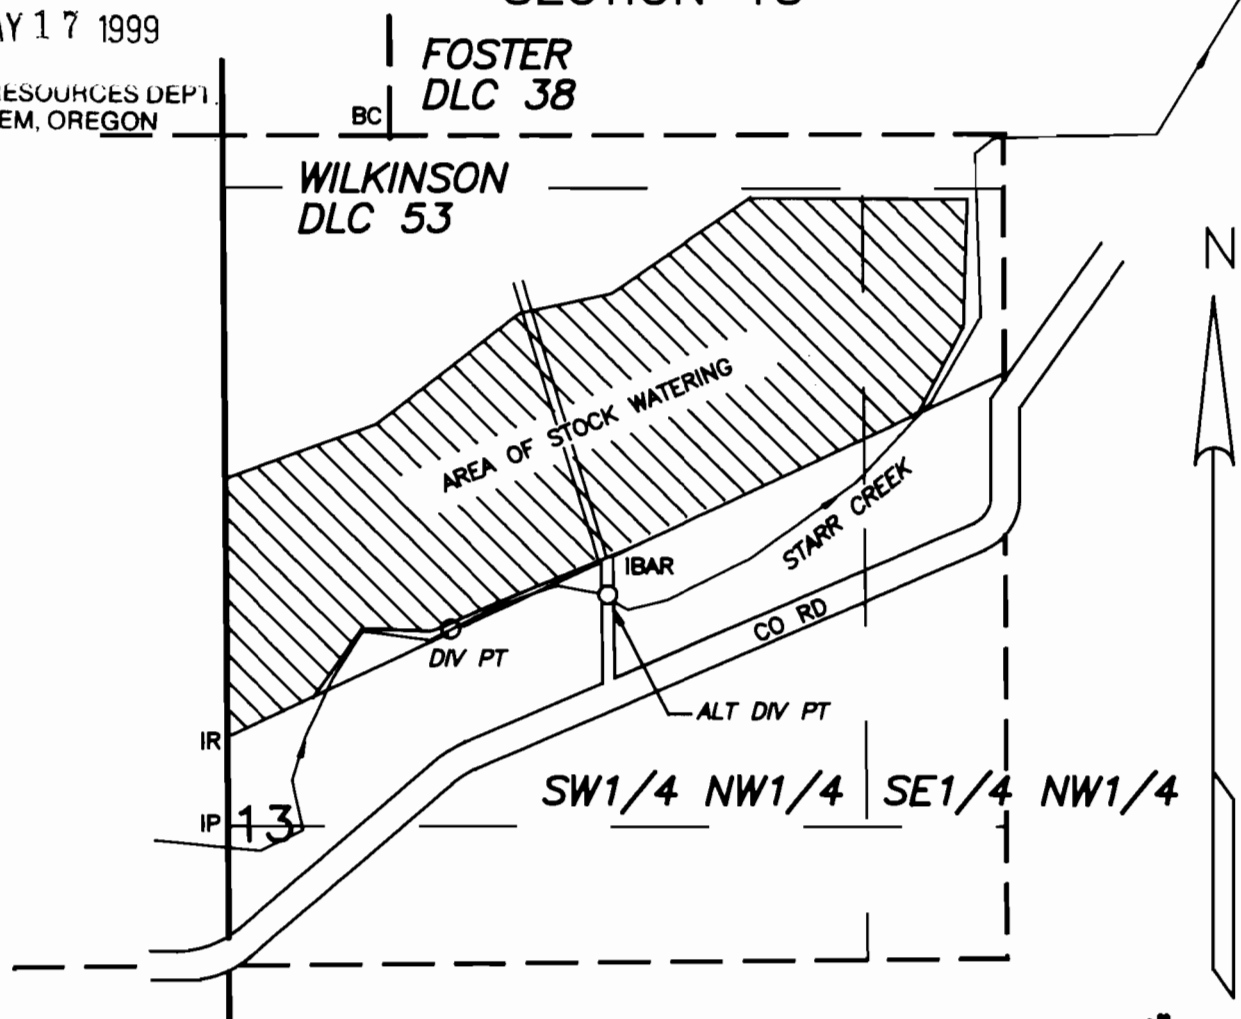

DIV PT - NORTH 410' & EAST 460' FROM THE WEST QUARTER CORNER, SEC 13
ALTERNATE DIV PT - NORTH 480' & EAST 790' FROM THE WEST QUARTER CORNER,
SEC 13., BOTH IN THE WILKINSON DLC NO 53.


1" = 400'

CLAIM OF BENEFICIAL USE MAP
for
SURFACE WATER

IN THE NAME OF
PATRICK L WILLS & MICHAELNE S WILLS

Prepared May 12, 1999
PARSONS SURVEYING
1915 S.E. Stone St.
Corvallis, OR 97333
(503) 752-7515
Project No. 9916

This map is for location of Water Right Application
only and does not constitute a boundary survey.

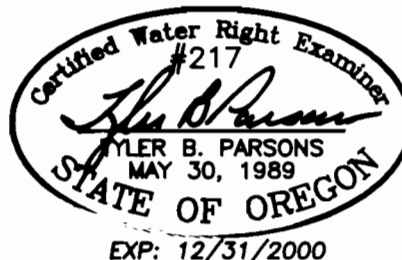

EXP: 12/31/2000