


SECTION 6, T.5 S., R.10 W., W.M.
TILLAMOOK COUNTY, OREGON

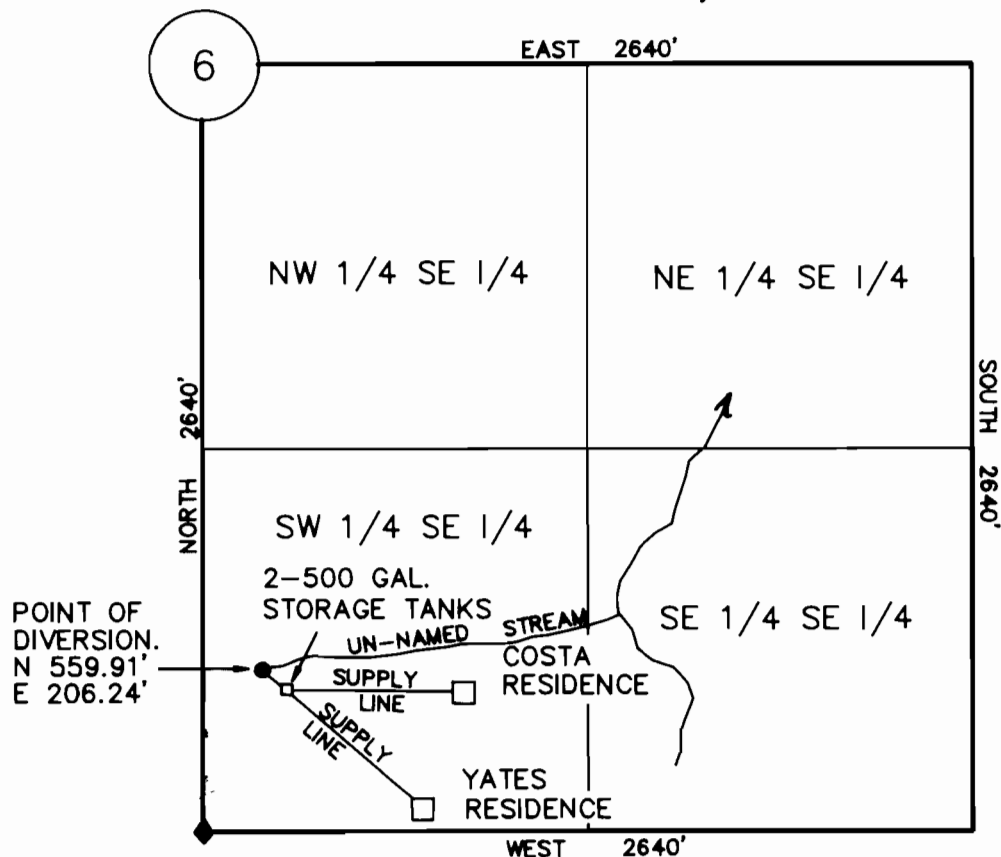

SCALE 1" = 660'


3" BRASS CAP
SOUTH 1/4 CORNER SEC. 6
N 0.00'
E 0.00'

IN THE NAME OF
BARBARA YATES AND JOHN COSTA

APPLICATION No. S-73070 PERMIT No. 52071 DATED APRIL 26, 1996

FINAL PROOF SURVEY

DATE: SEPTEMBER 28, 2000

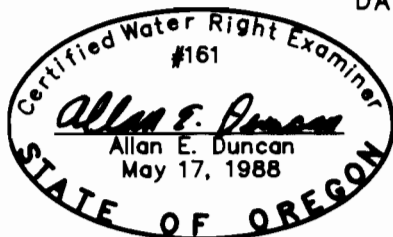

RECEIVED

OCT 4 3 2000

WATER RESOURCES DEPT.
SALEM, OREGON

THIS MAP IS FOR THE PURPOSE OF IDENTIFYING THE LOCATION OF THE WATER
RIGHT ONLY, AND IS NOT INTENDED TO PROVIDE LEGAL DIMENSIONS OR LOCATIONS
OF PROPERTY OWNERSHIP LINES.