


RECEIVED

SEP 27 1996

T 29 SOUTH, RANGE 15 WEST W.M.
COOS COUNTY, OREGON

WATER RESOURCES DEPT.
SALEM, OREGON

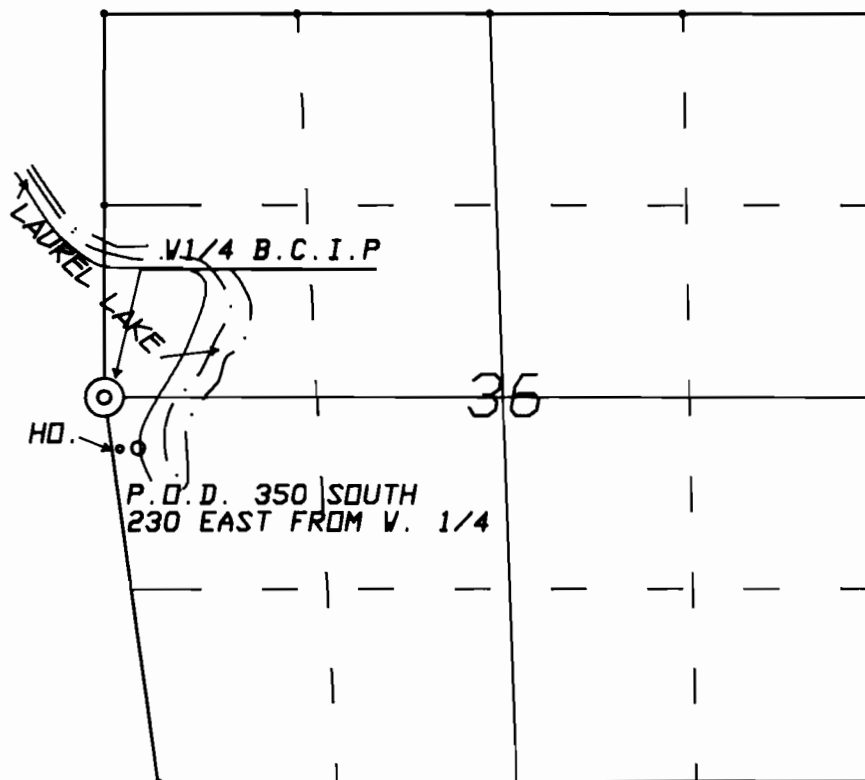


1" = 1320'

FINAL PROOF SURVEY

IN THE NAME OF
DOROTHY MacKERROW

UNDER PERMIT NO. 51569. APPL S 73015

SURVEYED SEPT 25, 1996 by JOHN PRAHAR
C.W.R.E 207

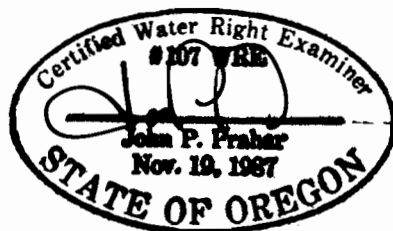

DISCLAIMER: THIS MAP WAS PREPARED FOR THE SOLE PURPOSE OF
LOCATING A WATER RIGHT AND IS NOT INTENDED TO SHOW OWNERSHIP
LINES