

CLAIM OF BENEFICIAL USE
FINAL PROOF MAP

Located in the NE $\frac{1}{4}$ SW $\frac{1}{4}$ of Section 6,
Township 34 South, Range 14 West, WM..
Coos County, Oregon
Application S-73354 Permit 52086

Scale 1"=400'


Prepared For: Tim Luberski
Prepared By: Dennis Goude
Date Prepared: June 11, 2002

NOTE

ALL DISTANCES ARE FROM THE CENTER
CORNER OF SECTION 6. THE P.O.D. IS
A 3 FOOT DIAMETER WELL TILE SET
IN THE CREEK. THE P.O.D. IS LOCATED
712 FEET SOUTH AND 180 FEET WEST.



EXPIRES 06/30/2003

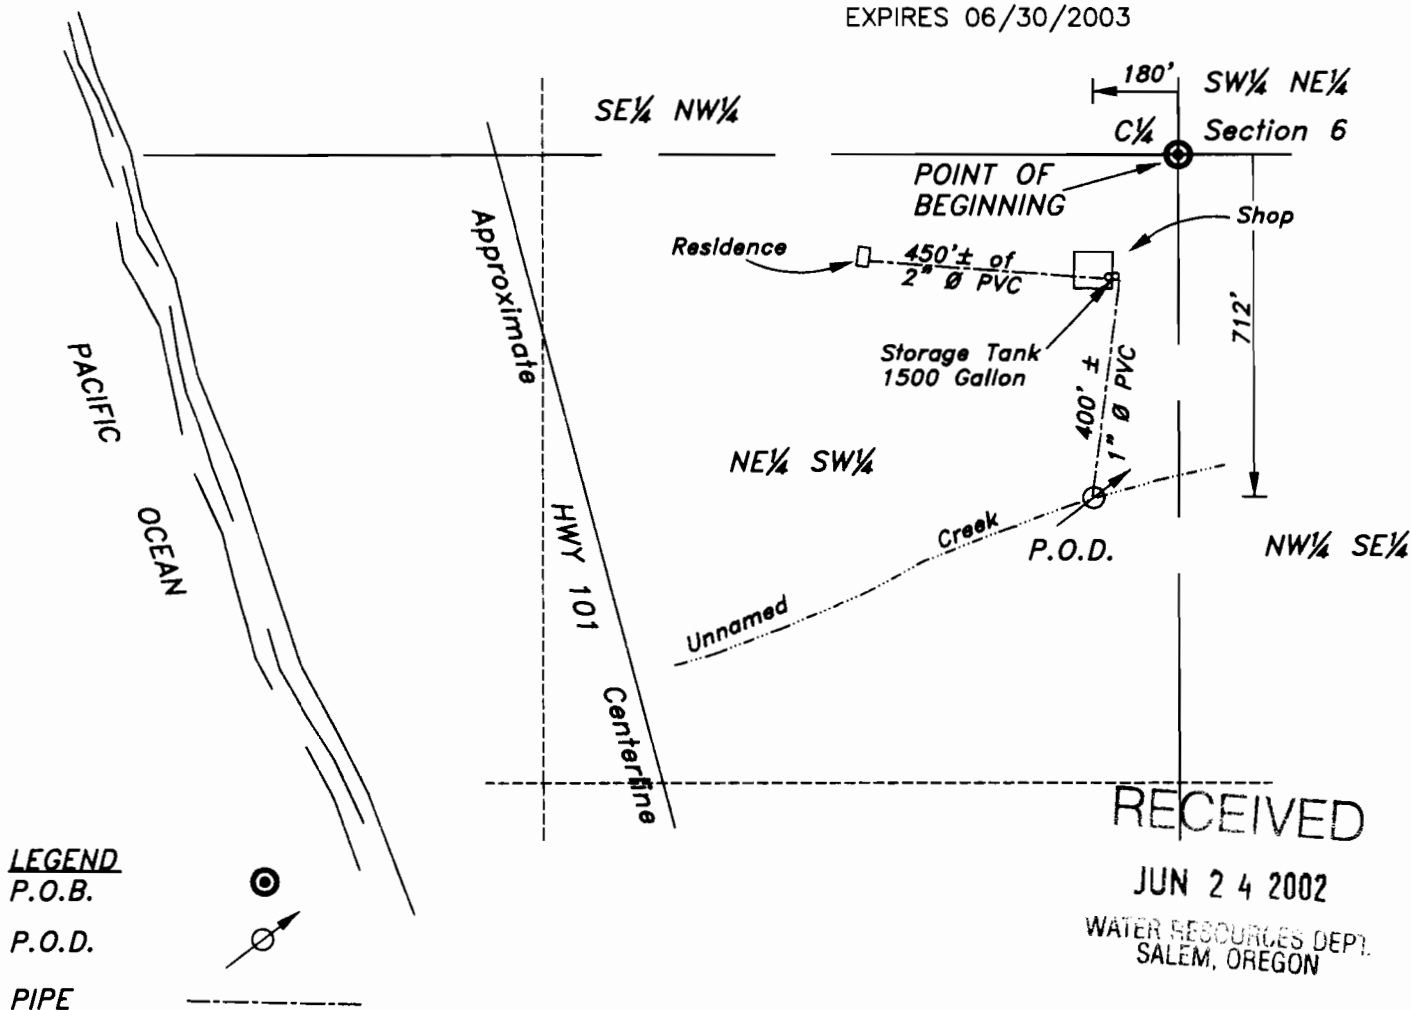

RECEIVED

JUN 24 2002

WATER RESOURCES DEPT.
SALEM, OREGON

EXAMINERS DISCLAIMER STATEMENT

The preparation of this map was for the purpose of
identifying the location of the Water Right only and
has no intent to provide dimensions or location of
property ownership lines.

Stuntzner Engineering
& Forestry, L.L.C.

ENGINEERING • LAND SURVEYING • FORESTRY
PLANNING • WATER RIGHTS

706 South 4th St.
Post Office Box 118
Coos Bay, Oregon 97600

Phone: (541) 267-2872
Fax: (541) 267-0588