


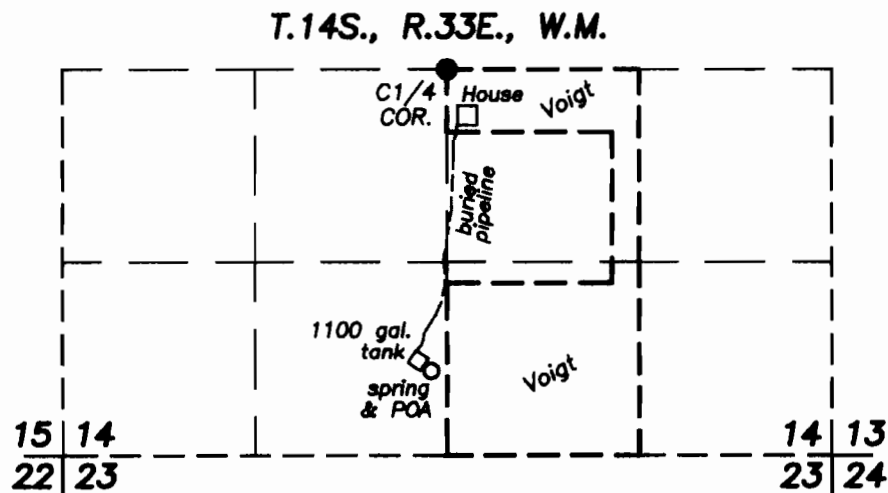

SCALE 1"=1320'

Spring & Point of Appropriation is 2060' S. and 110' W. of the C1/4 cor. Sec. 14.

● FD. MONUMENT OF RECORD
 -- PROPERTY LINE

**FINAL PROOF SURVEY
 UNDER**

APPLICATION NO. S-73298
 PERMIT NO. 52664

RECEIVED

SEP 14 2000

IN NAME OF
 DENNIS & THELMA VOIGT

SURVEYED AUG. 18, 2000 BY ROBERT BAGETT

WATER RESOURCES DEPT.
 SALEM, OREGON

NOTE: The preparation of this map was for the purpose of identifying the location of the proposed water right and has no intent to provide dimensions or location of property ownership lines.

