CLAIM OF BENEFICIAL USE
FINAL PROOF MAP
Located in the S½ SW¼ of Section 14, Township 29 South, Range 11 West, WM.. Coos County, Oregon
Application S-72247 Permit 53248

Scale 1"=400'

Prepared For: Thomas & Evelyn Coleman
Prepared By: Dennis Goude
Date Prepared: October 18, 2000

NOTE
ALL DISTANCES ARE FROM THE SOUTHWEST CORNER OF SECTION 14. P.O.D. A IS LOCATED 342.2 FEET NORTH AND 730.1 FEET EAST. P.O.D. B IS LOCATED 403.1 FEET NORTH AND 793.3 FEET EAST. P.O.D. C IS LOCATED 2282.4 FEET EAST AND 1184.5 FEET NORTH. P.O.D. A & B ARE SCREENED INSTREAM PIPES THAT GRAVITY TO A 1500 GALLON STORAGE TANK. P.O.D. C IS A SCREENED FOOT VALVE CONNECTED TO A TWO HORSEPOWER PUMP.

RECEIVED
OCT 3 1 2000
WATER RESOURCES DEPT.
SALEM, OREGON

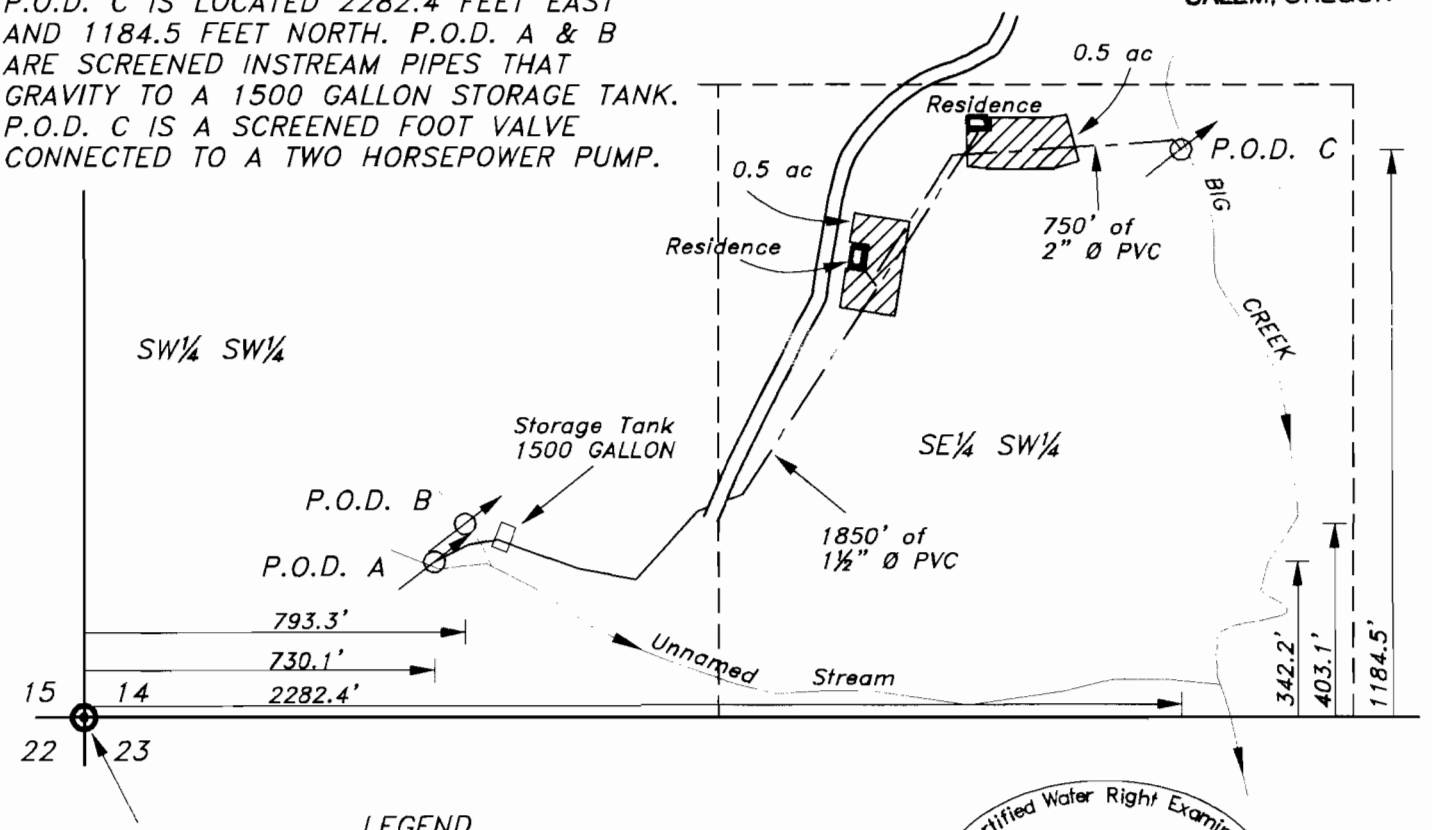

POINT OF BEGINNING

LEGEND
P.O.B.
P.O.D.
IRRIGATED AREA

Certified Water Right Examiner
441WRE
Thomas M. Hoshall
June 13, 1997
STATE OF OREGON

EXPIRES 06/30/2001

EXAMINERS DISCLAIMER STATEMENT
The preparation of this map was for the purpose of identifying the location of the Water Right only and has no intent to provide dimensions or location of property ownership lines.

00-228

Stuntzner Engineering & Forestry, L.L.C.
ENGINEERING • LAND SURVEYING • FORESTRY
PLANNING • WATER RIGHTS
705 South 4th St.
Post Office Box 118
Coos Bay, Oregon 97420
Phone: (541) 267-2872
Fax: (541) 267-0568