

RECEIVED



AUG - 6 1997

WATER RESOURCES DEPT.
SALEM, OREGON

T.3N., R.9W., W.M.

SECTION 7

TILLAMOOK COUNTY

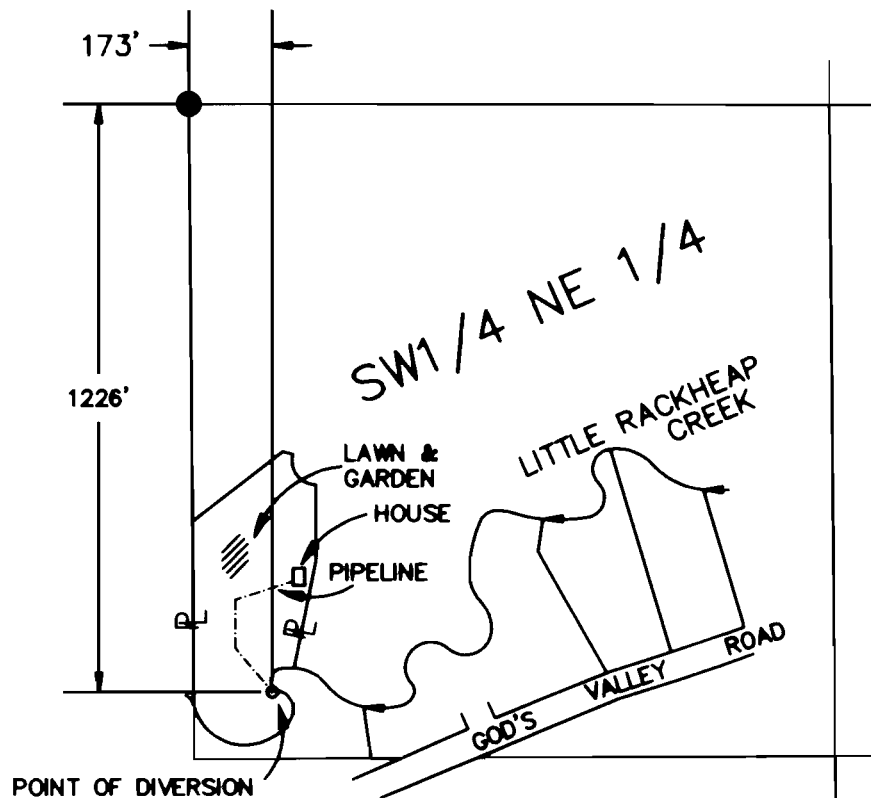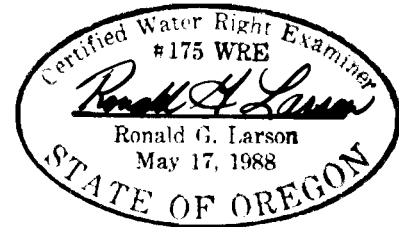

FINAL PROOF SURVEY

APPLICATION NO. 73429, PERMIT NO. 52069
IN THE NAME OF:
JOE GREGORAITIS
SURVEYED MARCH 26, 1997

SCALE:
1" = 400'

FILE: GREG-WR2.DWG

THE PURPOSE OF THIS MAP IS TO IDENTIFY
THE LOCATION OF THE WATER RIGHT. IT IS
NOT INTENDED TO PROVIDE INFORMATION
RELATIVE TO THE LOCATION OF PROPERTY
OWNERSHIP BOUNDARY LINES.

HLB & ASSOCIATES, INC.
P.O. BOX 219
MANZANITA, OR 97130
(503) 368-5394 FAX (503) 368-5847