


T. 8S., R. 21E., W.M.

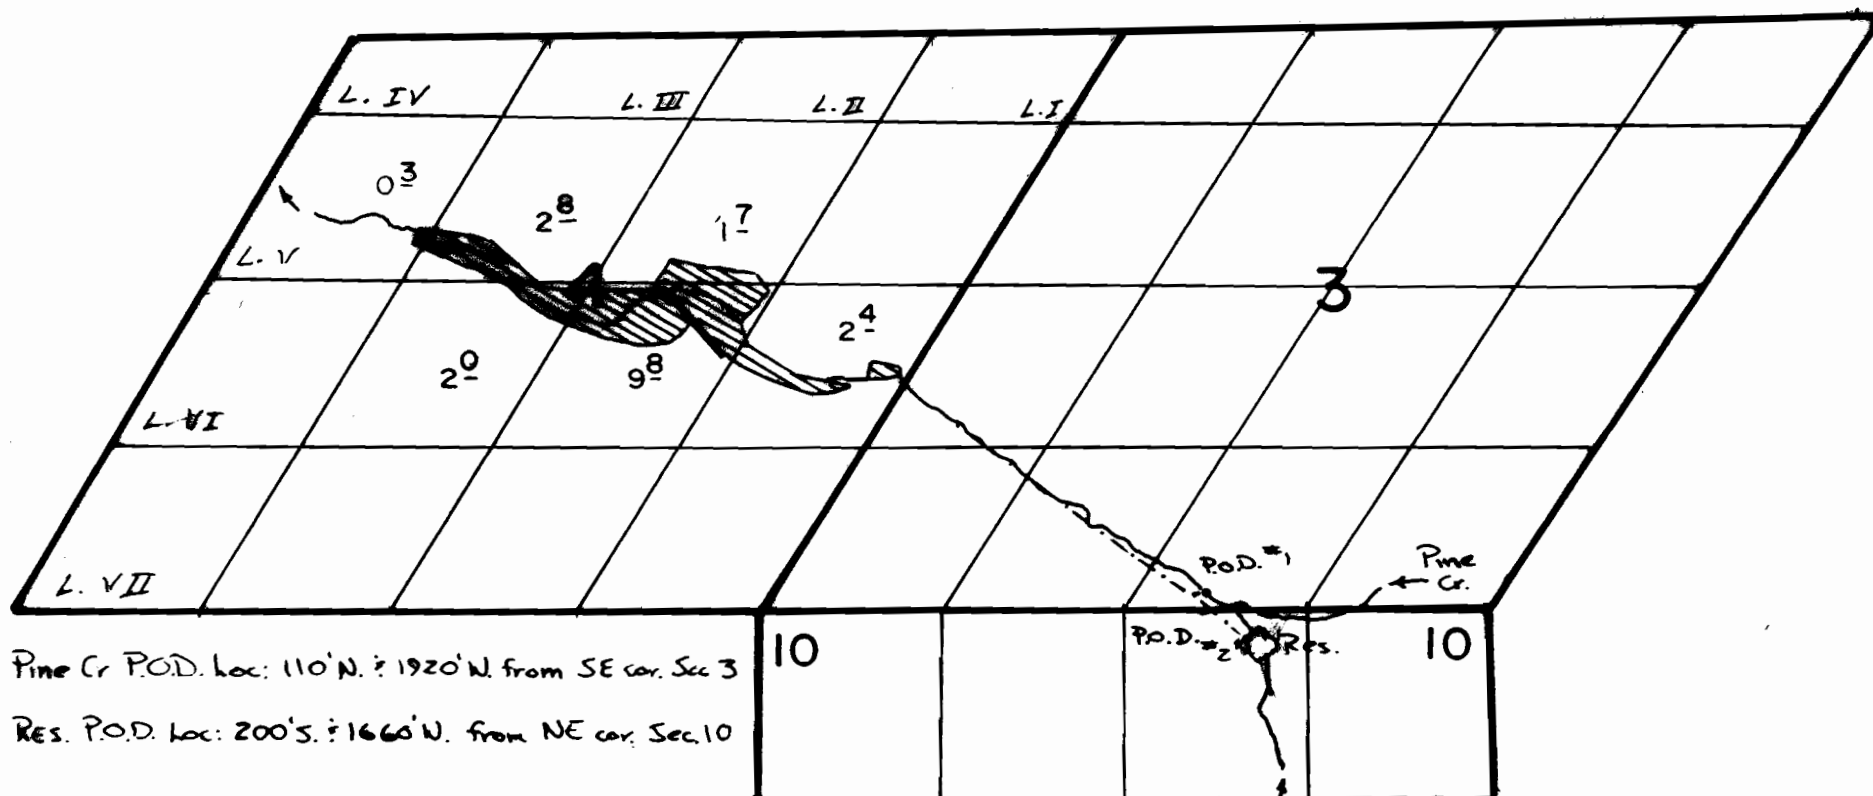

FINAL PROOF SURVEY

APPL. 60293
R-60292

PER. 45711
R-8262

TRANSFER 4806

IN NAME OF



SCALE 1" = 1320'

SURVEYED SEPT. 14, 2000 by vern church

MODIFY RES 4/11/08 LHN
CREEK 3/3/08 LHN
41069-179-1806 VLC