Map of Warner Ditch, No. 2, and vicinity.

Rpp 10657
Pen. No. 7322

vnship 14 S., Range 2 E, Willamette Meridian.

Line between Townships 13 and 14

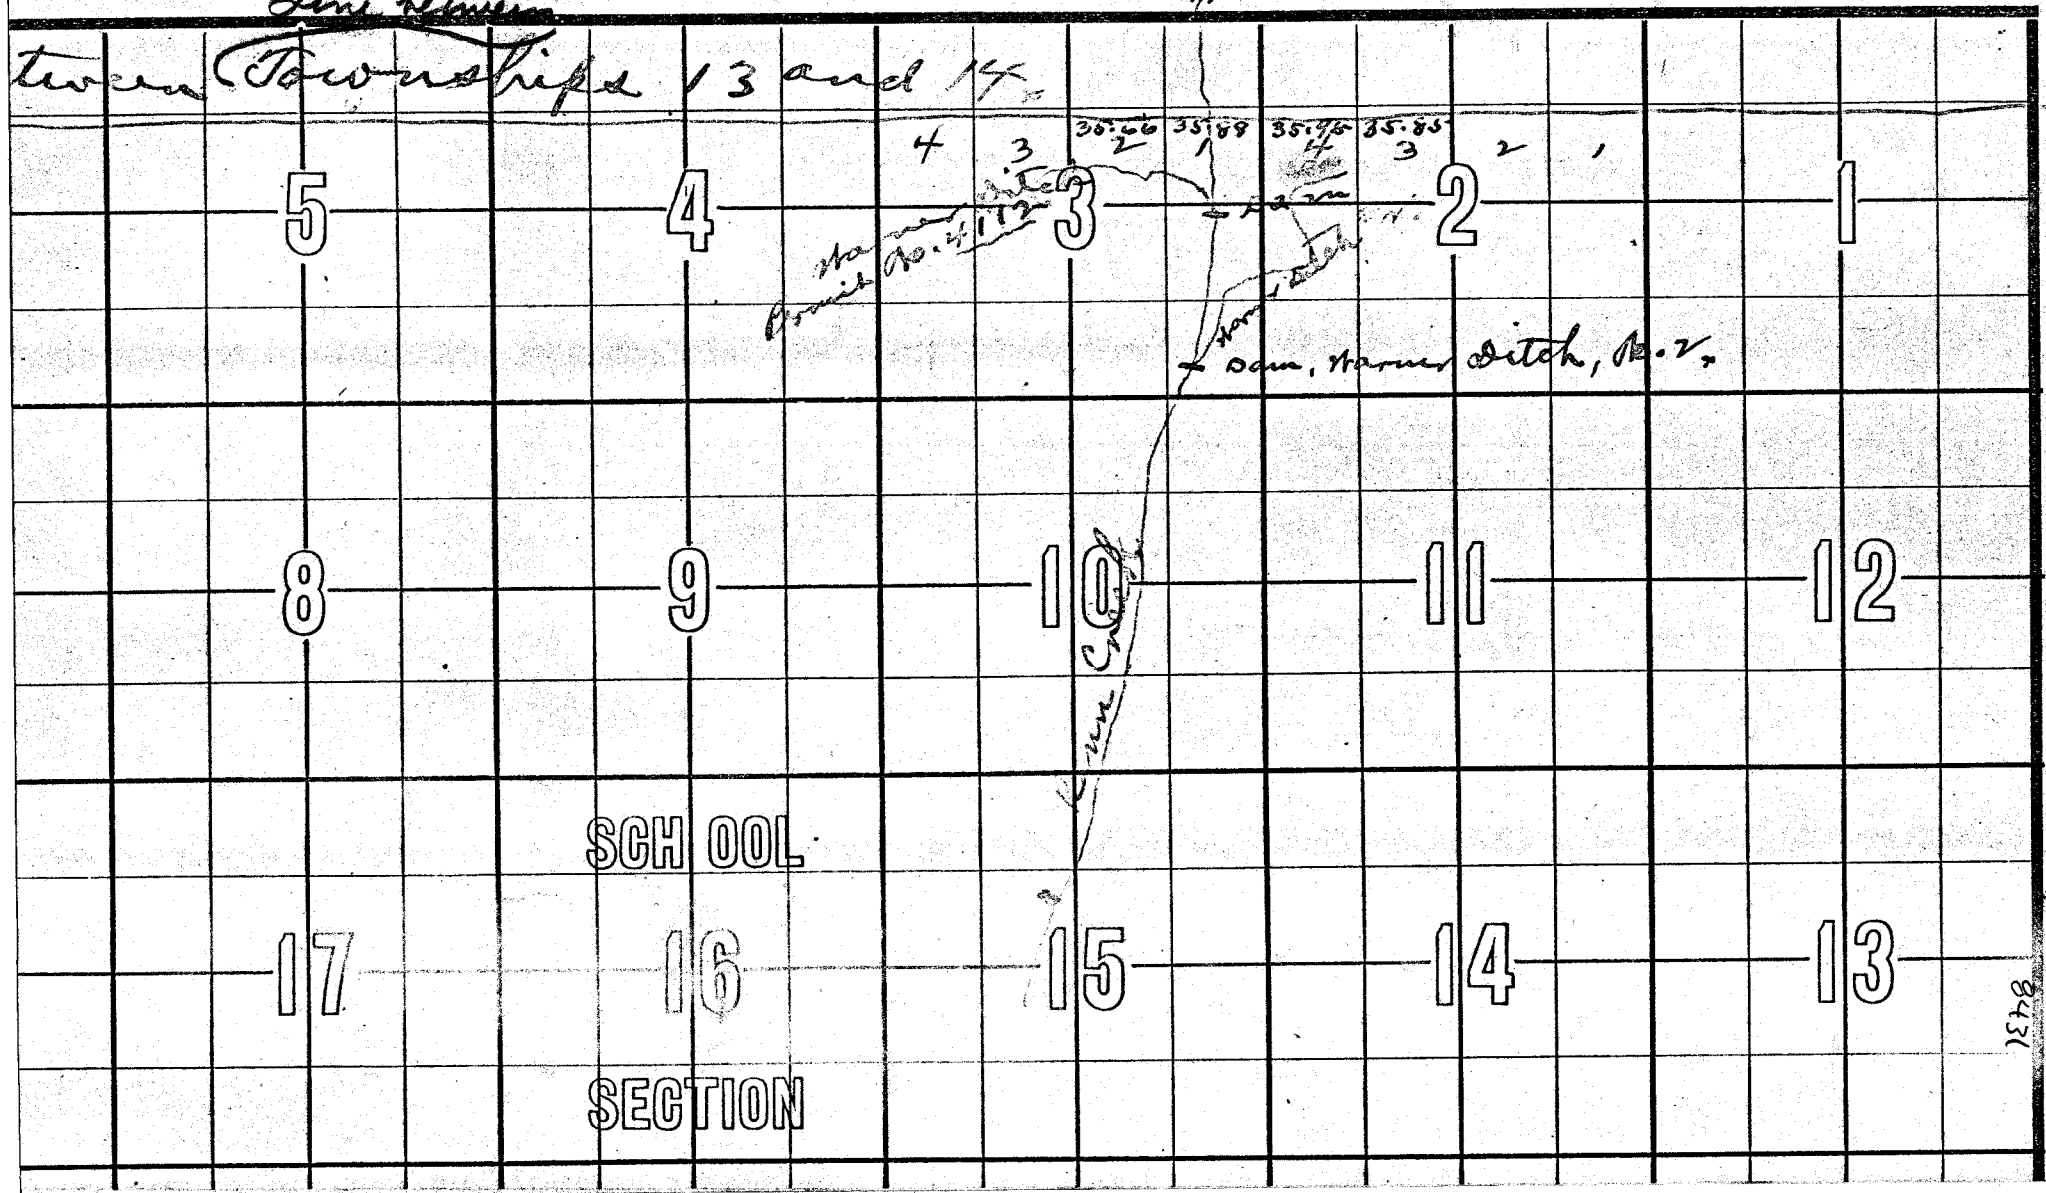


Pen 7322
8431