


TOWNSHIP 2 SOUTH, RANGE 3 WEST, W.M.

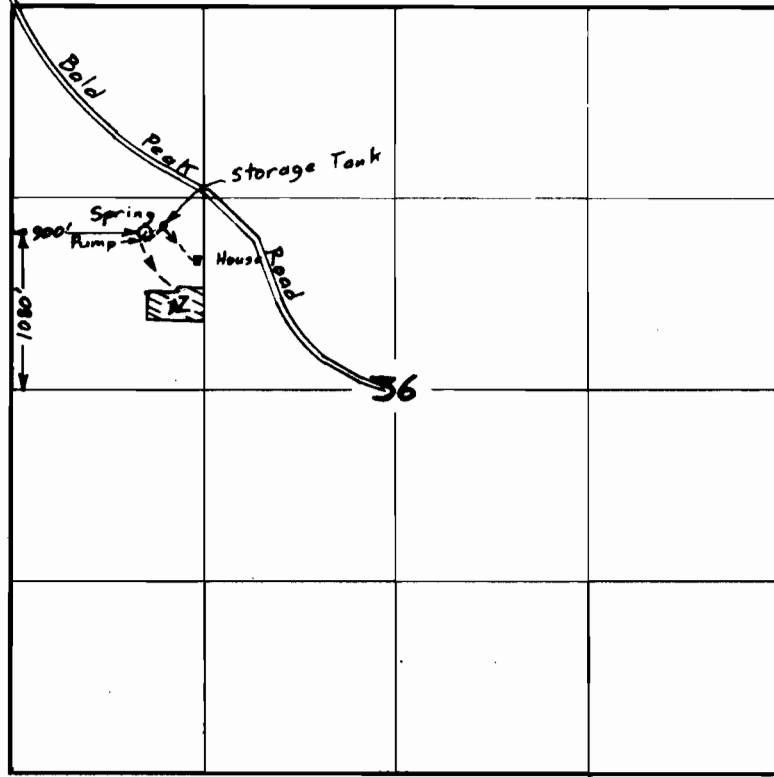

Scale 1" = 1320'

Surveyed August 10, 1994

CLAIM OF BENEFICIAL USE MAP
for
MARGARET THOMAS

Application 71115
Permit 51320

RECEIVED

OCT 18 1994

WATER RESOURCES DEPT.
SALEM, OREGON



This map is for the purpose of locating a water right only and has no intent to provide legal dimensions or the location of property lines.

Estes Surveys
6293 Sunnyview Rd. NE
Salem, OR 97305
585-7593