

RECEIVED

OCT - 1 1993

WATER RESOURCES DEPT.
SALEM, OREGON

K KRUMBEIN ENGINEERING LTD.
ENGINEERS - SURVEYORS - PLANNERS
361 S.E. Second Pendleton, Oregon

Scale
1"=600'
Date
9-28-93


Drn. By
DHK
Ckd. By

Drng. No.
9313A
Job No.
8929

Revision 1
Revision 2

FINAL PROOF SURVEY
FUJI ORCHARDS, INC.

W 1/2 SEC. 3, NE 1/4 SEC. 4
T. 5 N., R. 35 E. W. M.

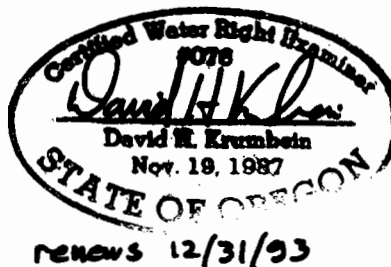

TRANSFER 6436