

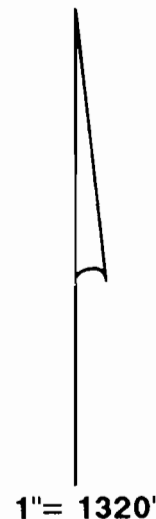


T.7S., R.3W., W.M.

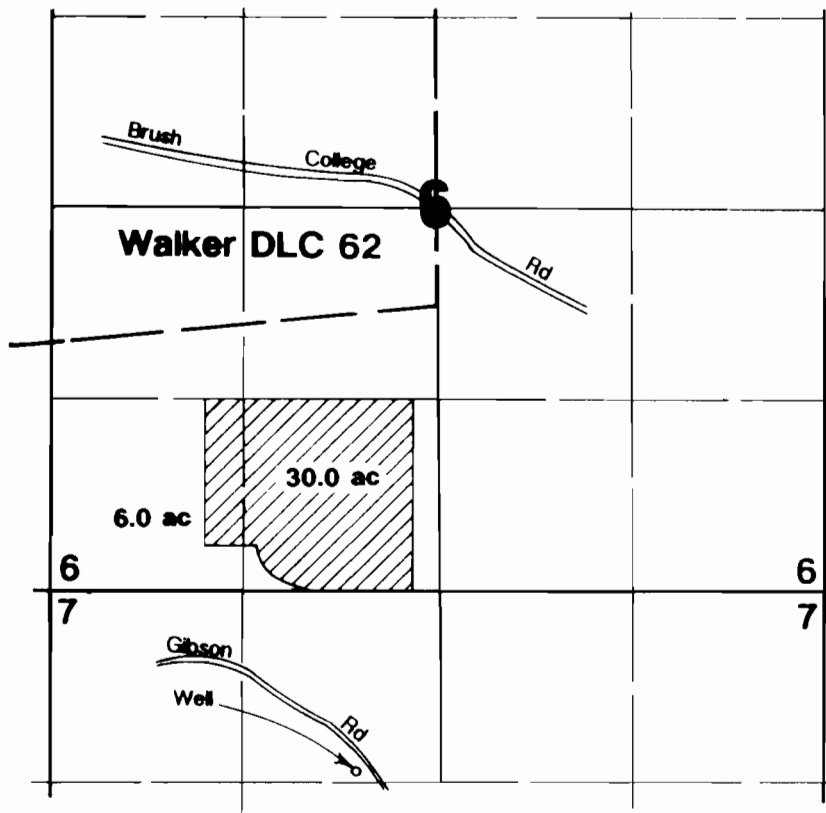

Well located 1230'S & 2060'E from SW corner Section 6.

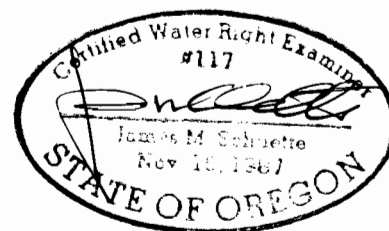

Final Proof Survey

Application #: G-12166 Permit #: G-11107

In Name Of

Don Meyer

Surveyed on September 28, 1993 by JM Schuette

RECEIVED
JUL 10 1993

WATER RESOURCES
SALEM, OREGON

THIS MAP WAS PREPARED FOR THE PURPOSE OF IDENTIFYING THE LOCATION OF A WATER RIGHT ONLY AND IS NOT INTENDED TO PROVIDE LEGAL DIMENSIONS OR LOCATION OF PROPERTY OWNERSHIP LINES.