


T. 34 S., R. 1 W., W.M.

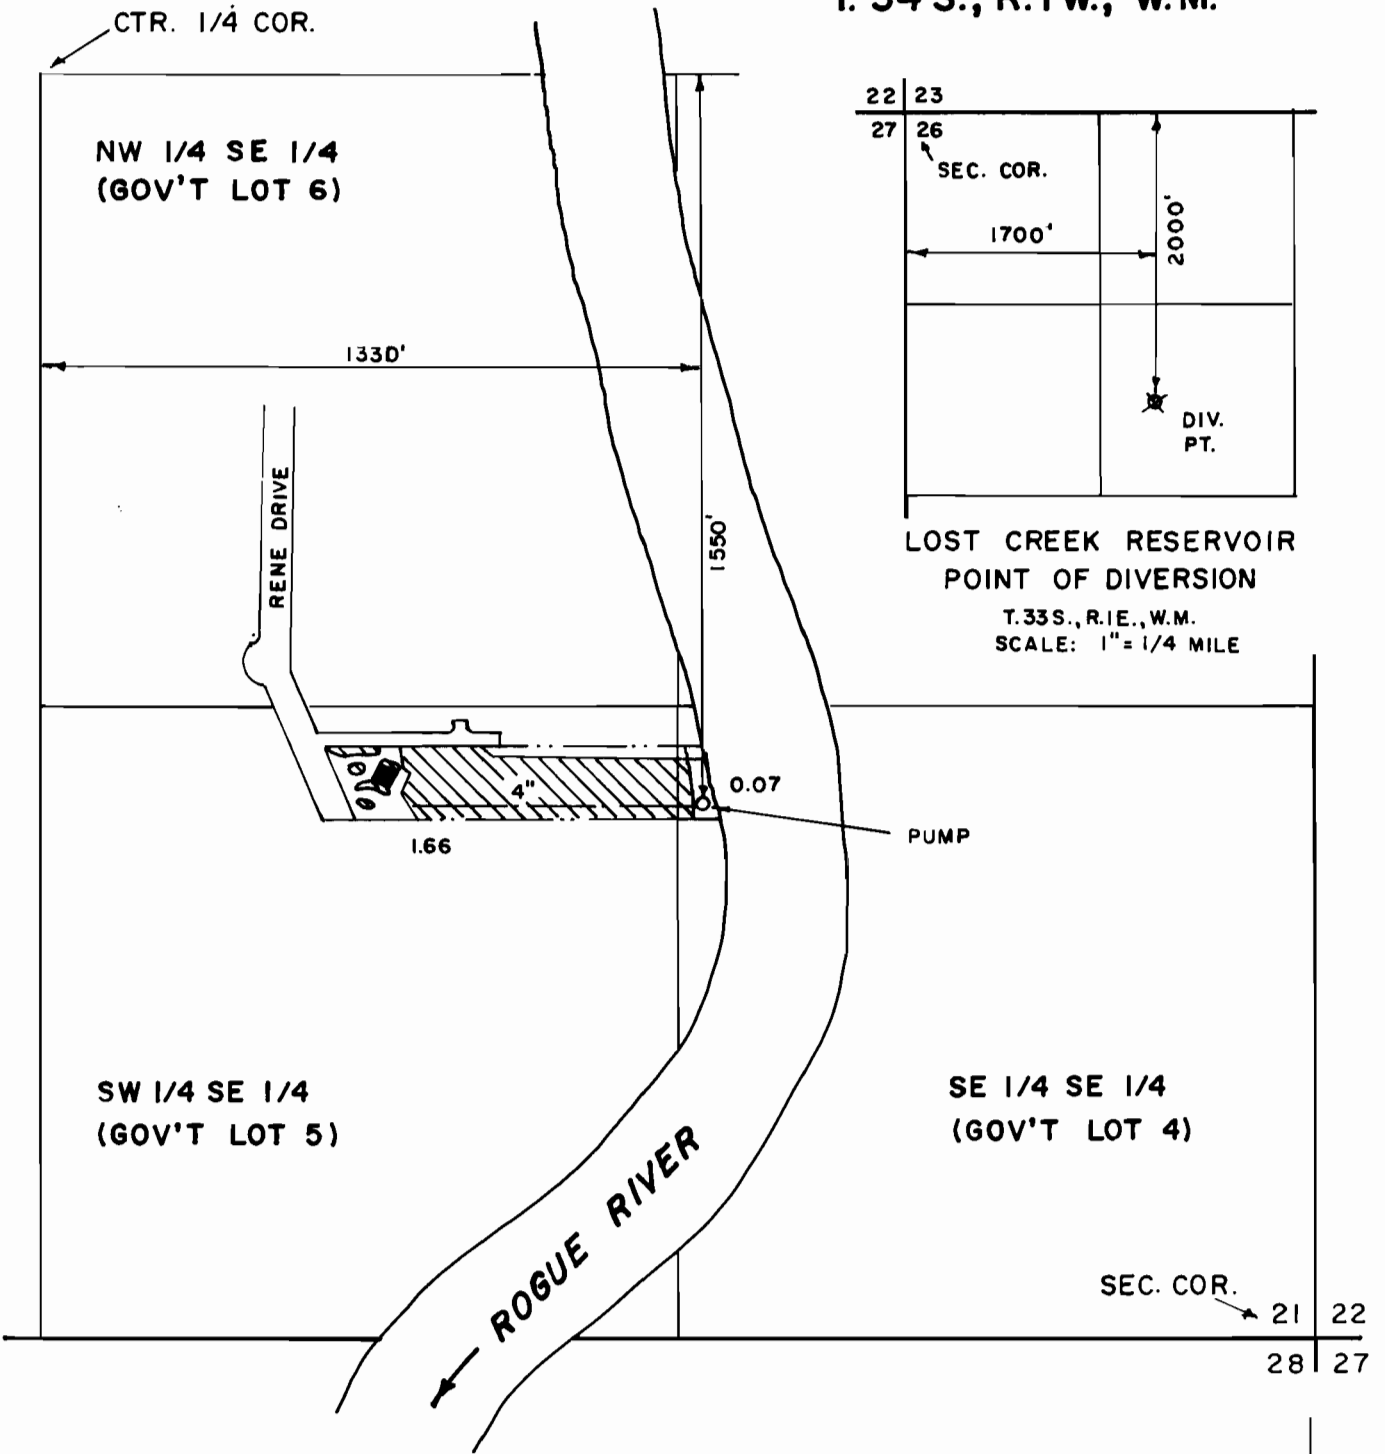

FINAL PROOF MAP


APPLICATION No. 69592 PERMIT No. 51238

IN THE NAME OF
BILL LITTLEFIELD

NOTE: MAP PREPARED FOR WATER
RIGHT PURPOSES ONLY, NOT FOR
PROPERTY BOUNDARY LOCATIONS

MAP PREPARED SEPTEMBER
14, 1994 BY GARY D. KAISER

J.D.K.

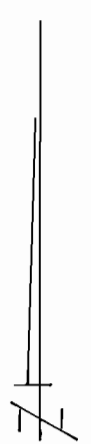

SCALE: 1" = 400'